

SECTION

LAND CORNER RECORDATION CERTIFICATE
Filing Requirement of Act 74, Mich. P.A. 1970

For corners in Lockport Twp.

| | | |
|------------------------------------|--|---------------|
| <u>St. Joseph</u> (County) | Located in: | Corner Code # |
| 1. Public Land Survey | T <u>6</u> S R <u>11</u> W | <u>E-9</u> |
| | T <u> </u> R <u> </u> | <u> </u> |
| | T <u> </u> R <u> </u> | <u> </u> |
| | T <u> </u> R <u> </u> | <u> </u> |
| 2. Property Controlling in Section | S <u> </u> T <u> </u> R <u> </u> | <u> </u> |
| | S <u> </u> T <u> </u> R <u> </u> | <u> </u> |
| 3. Miscellaneous Property in Sec. | S <u> </u> T <u> </u> R <u> </u> | <u> </u> |
| | S <u> </u> T <u> </u> R <u> </u> | <u> </u> |

LIBER **6** PAGE **9**
STATE OF MICHIGAN
ST. JOSEPH COUNTY
FILED

7 JAN 2000 9:48:15 AM

CYNTHIA L. JARRATT
REGISTER OF DEEDS

Register of Deeds Stamp & File Number

4. Lot No. _____, Recorded Plat _____
5. Private Claims _____

I, Wayne A. Mostrom, in a field survey on 8/4, 19 99 do hereby state that under requirements of P.A. 74, Michigan P.A. of 1970, the corner points mentioned in lines 1 and 2 above were in conformance with regulations and rules therefore as required in the current manual of survey instructions of the United States Department of the Interior, Bureau of Land Management or by a decree of a Court of Law and/or that the corner points mentioned in lines 3, 4 and 5 above were in conformance with the rules of the Michigan Board of Land Surveyors or by a Decree of a Court of Law; established, re-established, monumented, recovered, found as expressed below:

NOTE: Not more than 2 corners, all in the same town and range, may be recorded on this certificate.

| | | | | | | | | | | | | | |
|----|---|----|---|----|---|----|---|----|---|----|---|----|---|
| 1 | A | B | C | D | E | F | G | H | I | J | K | L | M |
| 2 | | 6 | | 5 | | 4 | | 3 | | 2 | | 1 | |
| 3 | | | | | | | | | | | | | |
| 4 | | 7 | | 8 | | 9 | | 10 | | 11 | | 12 | |
| 5 | | | | | | | | | | | | | |
| 6 | | 10 | | 17 | | 16 | | 15 | | 14 | | 13 | |
| 7 | | | | | | | | | | | | | |
| 8 | | 19 | | 20 | | 21 | | 22 | | 23 | | 24 | |
| 9 | | | | | | | | | | | | | |
| 10 | | 30 | | 29 | | 28 | | 27 | | 26 | | 25 | |
| 11 | | | | | | | | | | | | | |
| 12 | | 31 | | 32 | | 33 | | 34 | | 35 | | 36 | |
| 13 | | | | | | | | | | | | | |

A. Description of original monument and accessories and/or subsequent restoration:

1864 Survey in A/65

Stk. from old brg. tree

14" W.O.= N12°W 82 lks. (54.12')

6" Syc.= S38 3/4°E 57 1/2 lks (37.95')

Sayers 1974 Surveys & LCRC in L-2, Pg-3

☉ rd.= North 0.7'

28" Hick.= SW 78.5'

RR Tie A.P.= N. 35.0'

Pipe in Mon. box

Cor. is on bdy. of

"Rolling Acres" Sub.

1980 Mostrom Survey

refers to LCRC in

L-2, Pg-3

B. Description of corner evidence found and/or method applied in restoring or reestablishing corner:

Fd. 1 1/4" x 12" pipe in Mon. box In ☉ hwy. over stone 24" deep

Cor. is on fence and tree row to North

28" Hick.= SW 78.5'

RR Tie A.P.= N. 35'

Cor. checks plat of "Rolling Acres"

RATIFIED BY PEER GROUP
IN ACCORDANCE WITH P.A. 345

Jan 4, 1999
Wayne CO. REPRESENTATIVE

C. Description of monument for corner and accessories established to perpetuate locating the position of the corner:

Replaced pipe with 5/8" x 24" bar w/std. cap in Mon. box


N & W in N. side 36" Hick. = S70°W 79.80'

N & W in W. side P.P. = S20°E 80.59'

N & W in W. side P.P. = N15°E 34.67'

N & W in W. side cut-off P.P. = North 35.50'

Conc. Plat Monument = South 59.94'

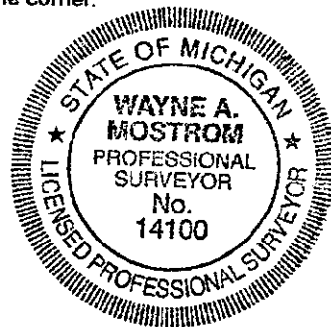

LIBER **6** PAGE **9**

Signed by Wayne A. Mostrom
Surveyor's Michigan License No. 14100

Date December 30, 1999