

**LAND CORNER RECORDATION CERTIFICATE**  
 Filing Requirement of Act 74, Mich. P.A. 1970

For corners in

St. Joseph Located in: Corner Code #  
 (County)  
 Lockport Twp.  
 1. Public Land Survey T6S R 11W F-11  
 T R  
 T R  
 T R  
 2. Property Controlling S T R  
 in Section S T R  
 3. Miscellaneous S T R  
 Property in Sec. S T R

**LIBER 5 PAGE 153**

STATE OF MICHIGAN  
 ST. JOSEPH COUNTY  
 FILED

27 APR 1999 1:20:03 PM

CYNTHIA L. JARRATT  
 REGISTER OF DEEDS

Register of Deeds Stamp & File Number

4. Lot No. \_\_\_\_\_, Recorded Plat \_\_\_\_\_  
 5. Private Claims \_\_\_\_\_

I, Wayne A. Mostrom, in a field survey on \_\_\_\_\_, 19 99 do hereby state that under requirements of P.A. 74, Michigan P.A. of 1970, the corner points mentioned in lines 1 and 2 above were in conformance with regulations and rules therefore as required in the current manual of survey instructions of the United States Department of the Interior, Bureau of Land Management or by a decree of a Court of Law and /or that the corner points mentioned in lines 3, 4 and 5 above were in conformance with the rules of the Michigan Board of Land Surveyors or by a Decree of a Court of Law; established, re-established, monumented, recovered, found as expressed below:

	A	B	C	D	E	F	G	H	I	J	K	L	M
1													
2	6		5		4		3		2		1		
3													
4	7		8		9		10		11		12		
5													
6	18		17		16		15		14		13		
7													
8	19		20		21		22		23		24		
9													
10	30		29		28		27		26		25		
11													
12	31		32		33		34		35		36		
13													

NOTE: Not more than 2 corners, all in the same town and range, may be recorded on this certificate.

**A. Description of original monument and accessories and/or subsequent restoration:**

1864 Survey In A/62 Road Comm. - 1960's  
 Stone set midway E to C Pipe in Mon. box  
 10" Hick. = N55°E 1.42 3/4 (94.22') 34" Oak = North 25.1  
 5" Cherry = S53 3/4°W 65 (42.9') 9" Cherry = S36°W 37.3'  
1906 Survey in B/262 Sayers 1964 Survey  
 + 'd stone found "Mon. Box"  
 18" Maple = N 1/2°E 56 2/3 (37.4')

Sayers 1977 Survey & LCRC in 2/1 (1975)

x'd sto. in Mon. box  
 36" Oak = North 24.09'  
 Cor. post = S5°E 20.24'  
 2.5' South of C


**B. Description of corner evidence found and/or method applied in restoring or reestablishing corner:**

Fd. + 'd stone in Mon. box 1.7' S. of C pavement  
 No fence to N., Fence to S. is 7.5'± E of cor.

**RATIFIED BY PEER GROUP  
 IN ACCORDANCE WITH P.A. 345  
 ON APRIL 19, 1999  
 WAM CO. REPRESENTATIVE**

**C. Description of monument for corner and accessories established to perpetuate locating the position of the corner:**

Set 5/8" x 10" bar w/std. cap over stone  
 In Mon. box  
 N & W in E. side 38" Oak = S13°E 32.09'  
 N & W in W. side Util. pole = S8°E 27.79'  
 N & W in S. side P.P. = N78°E 152.43'  
 N & W in S. side P.P. = N73°W 112.05'  
 NE cor. hse. fdtn. = S57°W 142.53'

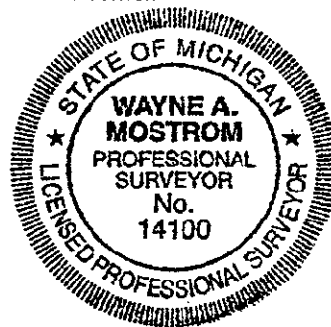

LIBER 5 PAGE 153

Signed by Wayne A. Mostrom  
 Surveyor's Michigan License No. 14100

Date 4/24/99

**REMONUMENTATION**