## SURVEY & REMONUMENTATION

JAN 2 2 1999

Surveyor's Michigan License No.\_\_


SECTION	Filing Require	R RECORDATION CERTIFIC ement of Act 74, Mich. P.A. 1 in County Remonumentation	310	PAGE 124 STATE OF K	COUNTY	
For corners in	Located In:	Corner Code #		FILED	I	
St. Joseph (County)	Lucateu m.	Corner Code #	7	7 700 1000	TEARSTA DM	
(County)			2	3 DEC 1998	TE40EON NU	
1. Public Land Survey	T 65 R 12W	A-5``		CVITHTAL	TADDATT	
Fabius Township			*	CYNTHIA L. REGISTER O		
NW Cor. Sec. 18	T R			KEDIDIEK U	L NECRO	
SW Cor. Sec. 7	. T R					
<b>5</b> 55 550. 1	TR					
2. Property Controlling S	TR					
in Section S	TR					
3. Miscellaneous S	TR					
Property in Sec. S	TR		Registe	er of Deeds S	tamp & File N	lumber
				•		
4. Lot No, Recorded	Plat		а в С	DEF	GHJJ	K T. N
5. Private Claims						<u> </u>
			2 - 6-	5 4	3-2-	—— i —
	•		3			
i, DALE L. KESLER	_, in a field survey on	<u>June 30</u> , 19 <u>98</u> do			10-11-	12
hereby state that under requirements of	f P.A. 74, Michigan P.A. of	1970, the corner points mentioned	4 7	8		
in lines 1 and 2 above were in confor- current manual of survey instructions of	mance with regulations and If the United States Departm	rules meretore as required in the	. 5		<del>                                     </del>	
Management or by a decree of a Cour	t of Law and /or that the co	rner points mentioned in lines 3, 4	6 -1,3-	1716	15-1-14-	1]3
and 5 above were in conformance wit						
Decree of a Court of Law; established	, re-established, monument	ed, recovered, found as expressed	8 19	30 31	22 23	21
below:				.   .		
NOTE: Not more than 2 corners, all in	o the same town and rance.	may be recorded	9			
on this certificate.	r the same town and range,	may ac recorded	10 30	2928	2726-	2,5
or dis cordinate.			21	_ -	<del>                                     </del>	
A. Description of original monume	ent and accessories-and/o	r subsequent restoration:	12 31	32:33:	34 35	36
*June 25, 1828 Calvin Britain—set 16" White Oak S 83 3/4° W 29.98 *August 2-3, 1864 G.H. Gardner 14 1/2° E 57 links. *July 1, 1924 Plat of Phillips Long *November 9, 1940 Old notes from North of iron post found concrete n *September 1966 St. Joseph Coun North 22.8 feet, Distance between *February 28, 1977 Michiana Surve	links, 14" White Oak N stake - old bearing tree Beach - E.L. Miner - bega n County Surveyors Offici narker for Southeast corn ty Road Commission - for Section corners - 18.8 fe	14 1/2° W 135 links. Witness: 14" Red Qak N en survey at point 165 feet Norte. Found iron post for Southwener of Sec. 12-6-13. und 1" pipe in place. Witness:	st corner of S 6" Twin mapl	ec. 7-6-12 - a e S 85 W 46	and about 20	
B. Description of corner evidence		<del>-</del>				
Found 1/2" iron pipe. Removed 241.85') North to the NW corne Joseph County Road Commission Subdivision. Accepted 1." iron p	er of Phillips Long Bead on measured jog and si pipe as the best eviden	ch Subdivision. This corner was of found monument and roce of the corner. See other	was establish measurement side for mea	ned from agi is from Philli surements t	reeing with ips Long Be to adjacent o	ach
•		established to perpetuate locati				
Set 5/8" x 24" rebar with cap o original corner.				tuation of th	e position o	if the
		e South 5 degrees West.	13,43]. 47 18!	ALLESS SALES	1111	
PK Nail with washer in No		South 80 degrees West	47.16' 32.45'	KE OF MIC	4/04	
Northeast Corner of House		South 28 degrees West	52.45 K	<b>b</b>	1. 2	
Northeast Corner Section	13, 103, H13W	North 18.80'	¥ 0	DALE L.	, , , ,	
			<b>.</b>	KESLER		-
	PATIFIF	BY PEER GROUP	<u> </u>	No.		
	IN ACCO	RDANCE WITH P.A. 345	£ 13	38117	. 8	50
		ov. 9, 1998		Wei	OVER 111	۲.,
		CO. REPRESENTATIVE	14	LAND S	RVETO TITLE	70
<u> </u>	1/			***************************************	tas.	Ä
Signed by	Keel			Date k	Jec 22	1996

38117

JAN 2 2 1999

SECTION

LIBER 5 PAGE 125

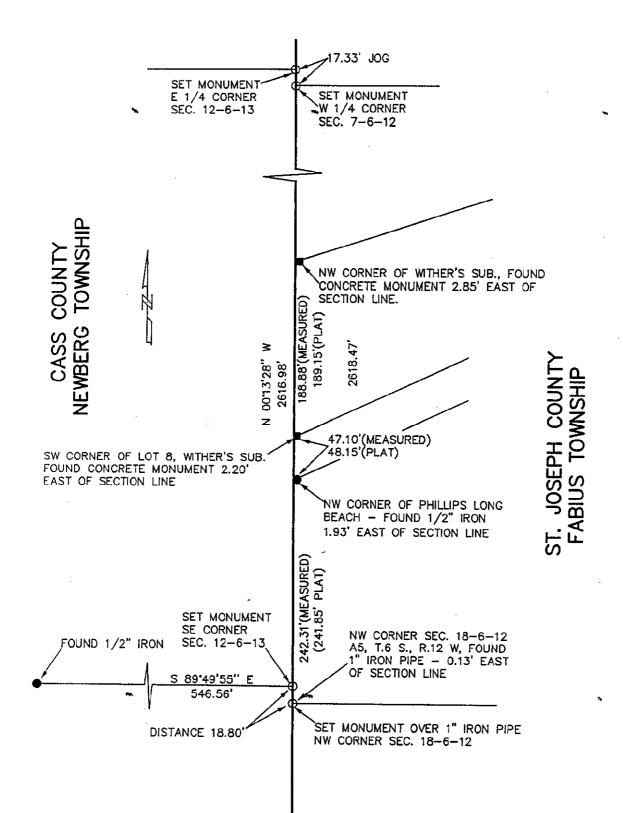

LIBER OF PAGE 12