

MAY 07 1997

COMMISSION

LAND CORNER RECORDATION CERTIFICATE
Filing Requirement of Act 74, Mich. P.A. 1970

LIBER 4 PAGE 284

For corners in

<u>ST. JOSEPH</u>	Located In:	Corner Code #
(County)		
SHERMAN TWP.		
1. Public Land Survey	T <u>7S</u> R <u>10W</u>	B-9
	T ___ R ___	_____
	T ___ R ___	_____
	T ___ R ___	_____
2. Property Controlling in Section	S ___ T ___ R ___	_____
	S ___ T ___ R ___	_____
3. Miscellaneous Property in Sec.	S ___ T ___ R ___	_____
	S ___ T ___ R ___	_____

STATE OF MICHIGAN
ST. JOSEPH COUNTY
FILED

10 DEC 96 2:28 P.M.

CYNTHIA JARRATT
REGISTER OF DEEDS

LIBER 4 PAGE 284

Register of Deeds Stamp & File Number

4. Lot No. _____, Recorded Plat _____
5. Private Claims _____

I, WAYNE A. MOSTROM, in a field survey on AUG. 12, 1996 do hereby state that under requirements of P.A. 74, Michigan P.A. of 1970, the corner points mentioned in lines 1 and 2 above were in conformance with regulations and rules therefore as required in the current manual of survey instructions of the United States Department of the Interior, Bureau of Land Management or by a decree of a Court of Law and /or that the corner points mentioned in lines 3, 4 and 5 above were in conformance with the rules of the Michigan Board of Land Surveyors or by a Decree of a Court of Law, established, re-established, monumented, recovered, found as expressed below:

NOTE: Not more than 2 corners, all in the same town and range, may be recorded on this certificate.

1	A	B	C	D	E	F	G	H	I	J	K	L	M
2		6		5		4		3		2		1	
3													
4		7		8		9		10		11		12	
5													
6		10		17		16		15		14		13	
7													
8		19		20		21		22		23		24	
9		⊙											
10		30		29		28		27		26		25	
11													
12		31		32		33		34		35		36	
13													

A. Description of original monument and accessories and/or subsequent restoration:

1864 SURVEY IN BK A, PG 70 & 72

1975 SURVEY & LCRC IN LIBER 2, PG 60

1983 & 1988 SURVEYS BY MOSTROM

SET STAKE FROM ORIGINAL BEARING TREES

8" HICK. = S14½°W 28 LKS
10" BL. OAK = N1½°W 36 LKS

MON. BOX OVER STONE
24" W.O. = N50°E 40.6'
12" HICK. = N75°W 94'
COR. IS IN \mathcal{C} RDWY

SHOWS SAME DATE FOUND AS IN LCRC IN LIBER 2, PG 60


B. Description of corner evidence found and/or method applied in restoring or reestablishing corner:

FOUND +1D STONE IN MON. BOX
24" W.O. = N50°E 40.6'
12" HICK. = N75°W 94'
COR. IS IN \mathcal{C} RDWY.
CAPPED IRON = SOUTH 33'

RATIFIED BY PEER GROUP
IN ACCORDANCE WITH P.A. 345
ON AUG. 12, 1996
Wayne CO. REPRESENTATIVE

C. Description of monument for corner and accessories established to perpetuate locating the position of the corner:

SET $\frac{5}{8}$ " X 6" IRON W/STD. CAP OVER STONE IN CONC. IN MON. BOX
N & W IN W. SIDE 38" OAK = N50°E 40.60'
N & W IN S. SIDE 26" HICK. = N75°W 94.0'
N & W IN E. SIDE 12" OAK = N26°E 34.25'
N & W IN W. SIDE 14" HICK. = N20°W 32.97'
IRON CAPPED #14100 = SOUTH 33.00'
(ALL NAILS & WASHERS WERE SET 24" ABOVE GRADE)

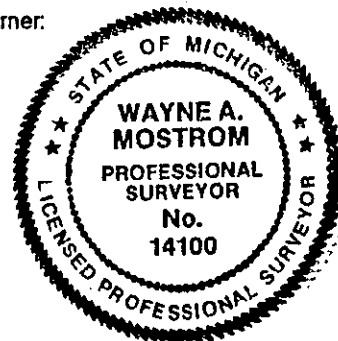

Signed by Wayne A. Mostrom
Surveyor's Michigan License No. 14100

Date DECEMBER 7, 1996

LIBER 4 PAGE 284