

JAN 17 1996

COMMISSION

LAND CORNER RECORDATION CERTIFICATE

Filing Requirement of Act 74, Mich. P.A. 1970 LIBER 4 PAGE 149

For corners in ST. JOSEPH Located In: _____ Corner Code #
(County)

- 1. Public Land Survey T 7 S R 10 W G-4
T _____ R _____
T _____ R _____
T _____ R _____
- 2. Property Controlling S _____ T _____ R _____
in Section S _____ T _____ R _____
- 3. Miscellaneous S _____ T _____ R _____
Property in Sec. S _____ T _____ R _____

- 4. Lot No. _____, Recorded Plat _____
- 5. Private Claims _____

STATE OF MICHIGAN
ST. JOSEPH COUNTY
FILED

19 MAY 95 2:33 P.M.

CYNTHIA JARRATT
REGISTER OF DEEDS

Register of Deeds Stamp & File Number

I, Donald C. Andrews, in a field survey on MAY, 1995, do hereby certify that under requirements of P.A. of 1970, the corner points mentioned in lines 1 and 2 above were in conformance with regulations and rules therefore as required in the current manual of survey instructions of the United States Department of the Interior, Bureau of Land Management or by a decree of a Court of Law and/or that the corner points mentioned in lines 3, 4 and 5 above were in conformance with the rules of the Michigan Board of Land Surveyors or a Decree of a Court of Law; established, re-established, monumented, re-monumented, recovered, found as expressed below:

NOTE: Not more than 4 corners, all in the same town and range, may be recorded on this certificate.

A. Description of original monument and accessories and/or subsequent restoration:

GLO - POST
SURVEY RECORD "A" P. 686 BY TODD 1895, SET STAKE, BRICK, STONE. USED BEARING TREES IN SETTING CORNER
LCRC 3, P. 110 PIPE IN MON BOX
LCRC 2, P. 290 1/2" PIPE IN MON BOX
VARIOUS SURVEYS BY SAYERS AND MOSTROM AND GOVE USED PIPE IN MON BOX. ONE WITNESS OF THE ABOVE ITEMS STILL EXIST
PWR. POLE SW 74.35 FT.

	A	B	C	D	E	F	G	H	I	J	K	L	M
2	6		5		4		3		2		1		
3													
4	7		8		9		10		11		12		
5													
6	18		17		16		15		14		13		
7													
8	19		20		21		22		23		24		
9													
10	30		29		28		27		26		25		
11													
12	31		32		33		34		35		36		
13													


RATIFIED BY PEER GROUP
IN ACCORDANCE WITH P.A. 345
ON MAY 8, 1995
Wam CO. REPRESENTATIVE

B. Description of corner evidence found and/or method applied in restoring or reestablishing corner:

FOUND 1/2" I.D. PIPE X 36" IN MON BOX. FOUND OLD TAR ROAD DOWN 2 FT WITH PIECES OF BRICK. AT 29" BELOW EXISTING ROAD SURFACE FOUND 4 BRICKS LAID FLAT IN A SQUARE. INSIDE DIM. 3-1/2"X3-1/2". PEER GROUP ACCEPTED CENTER OF BRICK SQUARE AS CORNER POINT.

C. Description of monument for corner and accessories established to perpetuate locating the position of the corner:

SET 5/8" IRON X 24" OVER CORNER POINT WITH ALUMINUM CAP
WITNESS: 12" HICKORY N55°W 41.68 FT, 10" TWIN OAK WEST 52.68 FT, 10" HICKORY S85°W 38.44 FT
PWR POLE S28°W 73.93 FT.

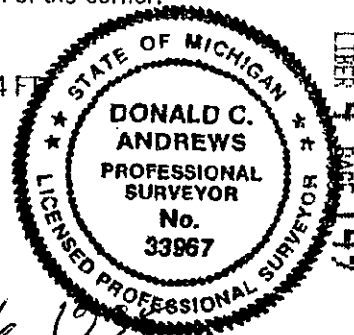

Signed by Donald C. Andrews
Donald C. Andrews, P.S.

Date May 16, 1995

Surveyor's Michigan License No. 33967