

SURVEY & MONUMENTATION
JAN 17 1996

COMMISSION

LAND CORNER RECORDATION CERTIFICATE
Filing Requirement of Act 74, Mich. P.A. 1970

For corners in ST. JOSEPH Located In: _____ Corner Code # _____
(County)

1. Public Land Survey T 7 S R 10 W _____ G-6
 T _____ R _____
 T _____ R _____
 T _____ R _____

2. Property Controlling S _____ T _____ R _____
 in Section S _____ T _____ R _____

3. Miscellaneous S _____ T _____ R _____
 Property in Sec. S _____ T _____ R _____

4. Lot No. _____, Recorded Plat _____

5. Private Claims _____

LIBER 4 PAGE 151

STATE OF MICHIGAN
ST. JOSEPH COUNTY
FILED

19 MAY 95 2:33 P.M.

CYNTHIA JARRATT
REGISTER OF DEEDS

Register of Deeds Stamp & File Number


I, Donald C. Andrews, in a field survey on MAY, 1995, do hereby certify that under requirements of P.A. of 1970, the corner points mentioned in lines 1 and 2 above were in conformance with regulations and rules therefore as required in the current manual of survey instructions of the United States Department of the Interior, Bureau of Land Management or by a decree of a Court of Law and/or that the corner points mentioned in lines 3, 4 and 5 above were in conformance with the rules of the Michigan Board of Land Surveyors or a Decree of a Court of Law; established, re-established, monumented, re-monumented, recovered, found as expressed below:

NOTE: Not more than 4 corners, all in the same town and range, may be recorded on this certificate.

A. Description of original monument and accessories and/or subsequent restoration:

GLO - POST
SURVEYOR'S RECORD "A", P. 700, CO. SURVEYOR REED - 1895 - X'D STONE OVER STAKE
LCRC 3, P. 114 PIPE IN MON BOX
SAYERS HAS USED PIPE IN MON BOX ON SURVEYS
WITNESS: A.P. WEST 33.26FT, A.P. EAST 33.43FT, PWR POLE N30°W 60.71FT

	A	B	C	D	E	F	G	H	I	J	K	L	M
2	6	5	4	3	2	1							
3													
4	7	8	9	10	11	12							
5													
6	18	17	16	15	14	13							
7													
8	19	20	21	22	23	24							
9													
10	30	29	28	27	26	25							
11													
12	31	32	33	34	35	36							
13													

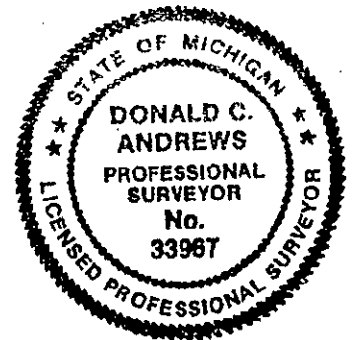

B. Description of corner evidence found and/or method applied in restoring or reestablishing corner:

FOUND 1/2" I.D. PIPE X 36" IN MON BOX. REMOVED PIPE AND MON BOX AND FOUND 5"X5" SQUARED STONE DOWN 2.1FT. PEER GROUP ACCEPTED STONE AS TRUE CORNER POINT.

RATIFIED BY PEER GROUP
IN ACCORDANCE WITH P.A. 345
ON May 8, 1995
Wiley CO. REPRESENTATIVE

C. Description of monument for corner and accessories established to perpetuate locating the position of the corner:

SET 5/8" IRON X 24" WITH ALUMINUM CAP OVER STONE.
WITNESS: A.P. WEST 33.75FT, FNC POST N55°W 40.70FT, PWR. POLE N30°W 60.59FT, A.P. EAST 33.88FT.

Signed by Donald C. Andrews
Donald C. Andrews, P.S.

Date May 16, 1995

Surveyor's Michigan License No. 33967

REMONUMENTATION

LIBER 4 PAGE 151