

REMONUMENTATION
NOV 6 1997
COMMISSION

LAND CORNER RECORDATION CERTIFICATE
Filing Requirement of Act 74, Mich. P.A. 1970 LIBER 5 PAGE 32

For corners in
ST. JOSEPH Located In: Corner Code #
(County)
1. Public Land Survey T 7S R 10W 1-11
T R
T R
T R
2. Property Controlling S T R
in Section S T R
3. Miscellaneous S T R
Property in Sec. S T R
4. Lot No. Recorded Plat
5. Private Claims

STATE OF MICHIGAN
ST. JOSEPH COUNTY
FILED
22 OCT 97 11:38 A.M.
CYNTHIA JARRATT
REGISTER OF DEEDS
Register of Deeds Stamp & File Number

I, Donald C. Andrews, in a field survey on SEPTEMBER 30, 19 97, do hereby certify that under requirements of P.A. of 1970, the corner points mentioned in lines 1 and 2 above were in conformance with regulations and rules therefore as required in the current manual of survey instructions of the United States Department of the Interior, Bureau of Land Management or by a decree of a Court of Law and/or that the corner points mentioned in lines 3, 4 and 5 above were in conformance with the rules of the Michigan Board of Land Surveyors or a Decree of a Court of Law; established, re-established, monumented, re-monumented, recovered, found as expressed below:

| | | | | | | | | | | | | | |
|----|----|----|----|----|----|----|---|---|---|---|---|---|---|
| | A | B | C | D | E | F | G | H | I | J | K | L | M |
| 2 | 6 | 5 | 4 | 3 | 2 | 1 | | | | | | | |
| 3 | | | | | | | | | | | | | |
| 4 | 7 | 8 | 9 | 10 | 11 | 12 | | | | | | | |
| 5 | | | | | | | | | | | | | |
| 6 | 18 | 17 | 16 | 15 | 14 | 13 | | | | | | | |
| 7 | | | | | | | | | | | | | |
| 8 | 19 | 20 | 21 | 22 | 23 | 24 | | | | | | | |
| 9 | | | | | | | | | | | | | |
| 10 | 30 | 29 | 28 | 27 | 26 | 25 | | | | | | | |
| 11 | | | | | | | | | | | | | |
| 12 | 31 | 32 | 33 | 34 | 35 | 36 | | | | | | | |
| 13 | | | | | | | | | | | | | |

NOTE: Not more than 4 corners, all in the same town and range, may be recorded on this certificate.

A. Description of original monument and accessories and/or subsequent restoration:

GLO POST
BOOK A, P 310 SURVEYOR TODD 1879 NO DESCRIPTION
BOOK B, P 398 SURVEYOR McCOY 1908 NO DESCRIPTION
BOOK A, P 320 NO DESCRIPTION
LCRC 2, P 272 3/4" PIPE IN MON. BOX. ANCHOR POST SOUTH 33.00' (R-M)
MOSTROM PIPE IN MON. BOX POPULAR S71°W 87.5' (R-M)

B. Description of corner evidence found and/or method applied in restoring or reestablishing corner:

FOUND 3/4" PIPE IN MON. BOX DISTANCE TO ANCHOR POST AND TO POPULAR TREE AGREED WITH THE RECORD. REMOVED FOUND PIPE AND MON. BOX. DUG HOLE 14" DIA. X 3.6' DEEP. AT DEPTH OF 24" TO 36" FOUND COBBLERS IN CIRCLE (PILE) UNDER BOX. AT 36" DEEP BOTTOM 20" DIA. TO INCLUDE UNDER EXISTING CENTERLINE ROAD. ACCEPTED CORNER AS BEST EVIDENCE OF POSITION.


RATIFIED BY PEER GROUP
IN ACCORDANCE WITH P.A. 345
ON OCT. 13, 1997
WATER CO. REPRESENTATIVE

C. Description of monument for corner and accessories established to perpetuate locating the position of the corner:

SET 5/8"x24" IRON WITH ALUM. CAP IN PLACE OF FOUND PIPE. 1) 3" OAK S5°E 33.62', 2) 10" PINE S55°E 44.92', 3) P. POLE N20°E 33.50', 4) 10" PINE S 55°E 44.92'

LIBER 5 PAGE 32

Signed by Donald C. Andrews
Donald C. Andrews, P.S.
Surveyor's Michigan License No. 33967

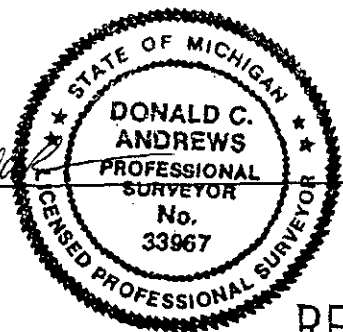

Date 09/30/97

FORM APPROVED BY MICHIGAN STATE BOARD OF LAND SURVEYORS, JAN. 28, 1971
REVISED MAY 14, 1975
REVISED JAN., 1983
ADAPTED FOR WORD-PROCESSING

REMONUMENTATION