

# SURVEY & REMONUMENTATION

SEP 12 1997

LAND CORNER RECORDATION CERTIFICATE  
Filing Requirement of Act 74, Mich. P.A. 1970 LIBER 4 PAGE 337

For corners in CONVECTION

<u>ST. JOSEPH</u>	Located in:	Corner Code #	
(County)			
FLORENCE TWP.			
1. Public Land Survey	T <u>75</u> R <u>11W</u>	<u>E-8</u>	
	T <u>   </u> R <u>   </u>	<u>   </u>	
	T <u>   </u> R <u>   </u>	<u>   </u>	
	T <u>   </u> R <u>   </u>	<u>   </u>	
2. Property Controlling in Section	S <u>   </u> T <u>   </u> R <u>   </u>	<u>   </u>	
	S <u>   </u> T <u>   </u> R <u>   </u>	<u>   </u>	
3. Miscellaneous Property in Sec.	S <u>   </u> T <u>   </u> R <u>   </u>	<u>   </u>	
	S <u>   </u> T <u>   </u> R <u>   </u>	<u>   </u>	

STATE OF MICHIGAN  
ST. JOSEPH COUNTY  
FILED  
  
18 APR 97 4:57 P.M.  
  
CYNTHIA JARRATT  
REGISTER OF DEEDS

Register of Deeds Stamp & File Number

4. Lot No. \_\_\_\_\_, Recorded Plat \_\_\_\_\_  
5. Private Claims \_\_\_\_\_

I, WAYNE A. MOSTROM, in a field survey on MARCH 28 19 97 do hereby state that under requirements of P.A. 74, Michigan P.A. of 1970, the corner points mentioned in lines 1 and 2 above were in conformance with regulations and rules therefore as required in the current manual of survey instructions of the United States Department of the Interior, Bureau of Land Management or by a decree of a Court of Law and /or that the corner points mentioned in lines 3, 4 and 5 above were in conformance with the rules of the Michigan Board of Land Surveyors or by a Decree of a Court of Law; established, re-established, monumented, recovered, found as expressed below:

NOTE: Not more than 2 corners, all in the same town and range, may be recorded on this certificate.

	A	B	C	D	E	F	G	H	I	J	K	L	M
1													
2	6		5		4		3		2		1		
3													
4	7		8		9		10		11		12		
5													
6	18		17		16		15		14		13		
7													
8	19		20		21		22		23		24		
9													
10	30		29		28		27		26		25		
11													
12	31		32		33		34		35		36		
13													

A. Description of original monument and accessories and/or subsequent restoration:

1892 SURVEY IN A/679	ROAD COMM. - 1963	1974 LCRC IN 1/63	1972 SURVEY BY GOVE ASSOC.
"A STONE SET BY ME SEVERAL YEARS AGO"	POINTED STONE IN BOX	BOX OVER IRON NAIL IN COR. POST =	1" PIPE IN MON. BOX
ORIG. WIT. =	13" OAK = N45°E 47.95'	EAST 31.7'	16" OAK = N40°E 47.76'
W.O. N32°E 115 LKS.	18" OAK = S68°E 39.15'	NAIL IN 25" OAK =	TWIN 6" BASS. = N85°E 37.05'
(GLO SHOWS TREE AS 10")	20" OAK = S40°E 60.0'	SE 42.04'	36" OAK = S45°E 41.99'


B. Description of corner evidence found and/or method applied in restoring or reestablishing corner:

FOUND POINTED STONE IN MON. BOX WITH BENT IRON OVER IT  
 24" DEAD OAK = N32°E 115 LKS.  
 20" OAK = N45°E 47.95'  
 24" OAK = S68°E 39.15'  
 20" STUMP = S40°E 60.0'  
 NAIL IN COR. POST = EAST 30.7'

RATIFIED BY PEER GROUP  
IN ACCORDANCE WITH P.A. 345  
ON April 14, 1997  
Wayne A. Mostrom CO. REPRESENTATIVE

C. Description of monument for corner and accessories established to perpetuate locating the position of the corner:

SET 5/8" X 8" BAR W/STD. CAP IN CONC. OVER STONE IN MON. BOX  
 N & W IN NW SIDE 20" OAK = N45°E 47.95'  
 N & W IN SW SIDE 24" OAK = S68°E 39.15'  
 N & W IN S. SIDE TWIN 12" BASSWOOD = N85°E 37.05'  
 N & W IN NW SIDE P.P. = S25°W 73.31'  
 N & W IN NE SIDE POLE = S20°E 83.75'  
 COR. IS IN Q N-S RDWY.

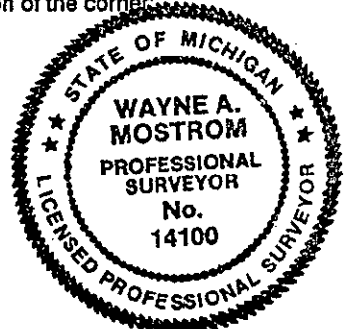

Signed by Wayne A. Mostrom  
 Surveyor's Michigan License No. 14100

Date 4/18/97

LIBER 4 PAGE 337

# REMONUMENTATION