

LAND CORNER RECORDATION CERTIFICATE
Filing Requirement of Act 74, Mich. P.A. 1970

For corners in
St. Joseph

(County)	Located In:	Corner Code #/
1. Public Land Survey	T 7S R 12W	A-4, B-4, A-3
	T R	
	T R	
	T R	
2. Property Controlling in Section	S T R	
	S T R	
3. Miscellaneous Property in Sec.	S T R	
	S T R	

Register of Deeds Stamp & File Number

4. Lot No. _____, Recorded Plat _____
 5. Private Claims _____

I, Donald L. Bissell, in a field survey on October, 19 89, do hereby certify that under requirements of P.A. 74, Michigan P.A. of 1970, the corner points mentioned in lines 1 and 2 above were in conformance with regulations and rules therefore as required in the current manual of survey instructions of the United States Department of the Interior, Bureau of Land Management or by a decree of a Court of Law and/or that the corner points mentioned in lines 3, 4 and 5 above were in conformance with the rules of the Michigan Board of Land Surveyors or by a Decree of a Court of Law; established, re-established, monumented, re-monumented, recovered, found as expressed below:

NOTE: Not more than 4 corners, all in the same town and range, may be recorded on this certificate.

	A	B	C	D	E	F	G	H	I	J	K	L	M
2	6		5		4		3		2				
3	7												
4	8		8		9		10		11		12		
5													
6	18		17		16		15		14		13		
7													
8	19		20		21		22		23		24		
9													
10	30		29		28		27		26		25		
11													
12	31		32		33		34		35		36		
13													

A. Description of original monument and accessories and/or subsequent restoration:

B. Description of corner evidence found and/or method applied in restoring or reestablishing corner:

<p>A-4 NW Cor. Sec. 7 Set 4" x 36" Conc. Mon w/alum. cap midway between the NW Cor. Sec. 7 and SW Cor. Sec. 7</p>	<p>B-4 Center Sec. 7 Set 4" x 36" Conc. Mon. @ intersection of 1/4 lines</p>	<p>A-3 NW Cor. Sec. 7 Found 1/2" rod in Mon. box 1' below Road surface</p>
--	---	---


C. Description of monument for corner and accessories established to perpetuate locating the position of the corner:

<p>A-4 NW Cor. Sec. 7 4" x 36" Conc. Mon. w/alum cap N22°E - 2.30' - Angle iron Fence Cor. N61°E - 5.07' - 14" Cherry S40°E - 19.21' - 10" Sassafrass South - 24.44' - 14" W. Oak</p>	<p>B-4 Center Sec. 7 4" x 36" Conc. mon. N07°E - 7.58' - 12" Elm N61°E - 34.36' - 10" Cherry S87°W - 9.47' - 6" Swamp Oak N65°W - 27.59' - 15" Hemlock</p>	<p>A-3 NW Cor. Sec. 7 1/2" rod N49°E - 36.55' - 36" E. Oak S54°E - 60.83' - 15" Cherry S88°W - 39.78' - 6" Maple N45°W - 50.59' - 5" W. Oak North - 82.50' - 1/2" rod NE Cor. Sec. 12 T7S, R13W</p>
---	---	---

Signed by Donald L. Bissell

Date 10-28-89

Surveyor's Michigan License No. 18655

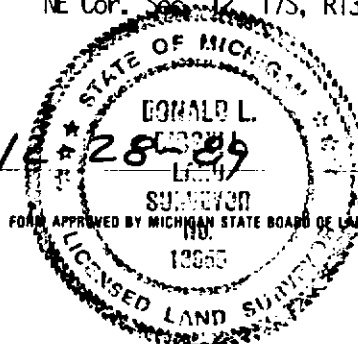

FORM APPROVED BY MICHIGAN STATE BOARD OF LAND SURVEYORS, JAN. 28, 1971
 REVISED MAY 14, 1975
 REVISED JAN., 1983