

LAND CORNER RECORDATION CERTIFICATE
Filing Requirement of Act 74, Mich. P.A. 1970

For corners in

<u>St. Joseph</u> <small>(County)</small>	Located In:	Corner Code <u>77</u>
1. Public Land Survey	T 7S R 12W	B-5, A-5, B-4
	T R	
	T R	
	T R	
2. Property Controlling in Section	S T R	
	S T R	
3. Miscellaneous Property in Sec.	S T R	
	S T R	

Register of Deeds Stamp & File Number

4. Lot No. _____, Recorded Plat _____
 5. Private Claims _____

I, Donald L. Bissell, in a field survey on October, 19 89, do hereby certify that under requirements of P.A. 74, Michigan P.A. of 1970, the corner points mentioned in lines 1 and 2 above were in conformance with regulations and rules therefore as required in the current manual of survey instructions of the United States Department of the Interior, Bureau of Land Management or by a decree of a Court of Law and/or that the corner points mentioned in lines 3, 4 and 5 above were in conformance with the rules of the Michigan Board of Land Surveyors or by a Decree of a Court of Law; established, re-established, monumented, re-monumented, recovered, found as expressed below:

	A	B	C	D	E	F	G	H	I	J	K	L	M
2		6		5		4		3		2		1	
3													
4													
NOTE: Not more than 4 corners, all in the same town and range, may be recorded on this certificate.

A. Description of original monument and accessories and/or subsequent restoration:

B-5	A-5
GLO Witnesses	GLO Witnesses
11" W. Oak - S37°W - 29 lks	13" W. Oak - N29 1/2° E - 80 lks
10" Y. Oak - N52°W - 17 lks	9" W. Oak - S36°E - 24 lks

B. Description of corner evidence found and/or method applied in restoring or reestablishing corner:


B-5	A-5	B-4
1/4 Cor. Sec. 7	SW Cor. Sec. 7	Center Section 7
Found stump of original witness, 10" Y. Oak	Found Rotted and Decayed Remains of Original witness,	Set 4' x 36" Conc. Mon. w/alum cap at intersection of 1/4 lines.
N52°W - 17 lks, fits swamp tie to west, 2 chains, used distance from center section 18, 1888 survey by Todd.	9" W. Oak - S36°E - 24 lks	
Set 4" x 36" conc. mon. w/alum cap.	Set 4" x 36" Conc. Mon. w/alum cap at G.L.O. Jog in very old North-South fence line.	

C. Description of monument for corner and accessories established to perpetuate locating the position of the corner:

B-5	A-5	B-4
1/4 Cor. Sec. 7	SW Cor. Sec. 7	Center Section 7
4" x 36" Conc. Mon.	4" x 36" Conc. Mon.	N7°E - 7.58' - 12" Elm
N50°W - 12' - center of stump (original wit.)	N45°E - 23.79' - 5" Ash	N61°E - 34.36' - 10" Cherry
S59°E - 30.12' - 10" W. Pine	S22°E - 12.95' - 5" Ash	S87°W - 9.47' - 6" Swamp Oak
South - 13.37' - 10" W. Pine	N77°W - 18.03' - 6" Hickory	N65°W - 27.59' - 15" Hemlock
N54°W - 26.50' - 5" W. Pine	N26°W - 35.20' - 15" Cherry	All trees blazed, spike & Tag
N50°E - 40.18' - 12" Beech	N4°E (Mag) - 76.50' - 4" Conc. Mon.	
All trees blazed, spike & tag	All trees blazed, Spike & Tag.	

Signed by Donald L. Bissell

Date

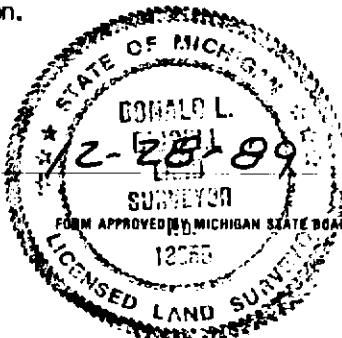

Surveyor's Michigan License No. 18655