

LAND CORNER RECORDATION CERTIFICATE
Filing Requirement of Act 74, Mich. P.A. 1970

For corners in

<u>St. Joseph</u> <small>(County)</small>	Located In:	Corner Code: <u>##</u>
1. Public Land Survey	T <u>7S</u> R <u>12W</u>	<u>A-8</u>
	T R	
	T R	
	T R	
2. Property Controlling in Section	S T R	
	S T R	
3. Miscellaneous Property in Sec.	S T R	
	S T R	
4. Lot No. _____, Recorded Plat		
5. Private Claims _____		

Register of Deeds Stamp & File Number

I, Donald L. Bissell, in a field survey on October, 19 89, do hereby certify that under requirements of P.A. 74, Michigan P.A. of 1970, the corner points mentioned in lines 1 and 2 above were in conformance with regulations and rules therefore as required in the current manual of survey instructions of the United States Department of the Interior, Bureau of Land Management or by a decree of a Court of Law and/or that the corner points mentioned in lines 3, 4 and 5 above were in conformance with the rules of the Michigan Board of Land Surveyors or by a Decree of a Court of Law, established, re-established, monumented, re-monumented, recovered, found as expressed below:

NOTE: Not more than 4 corners, all in the same town and range, may be recorded on this certificate.

	A	B	C	D	E	F	G	H	I	J	K	L	M
2	6		5		4		3		2		1		
3													
4	7		8		9		10		11		12		
5													
6	15		17		16		15		14		13		
7													
8	19		20		21		22		23		24		
9													
10	30		29		28		27		26		25		
11													
12	31		32		33		34		35		36		
13													

A. Description of original monument and accessories and/or subsequent restoration:

B. Description of corner evidence found and/or method applied in restoring or reestablishing corner:


A-8 W 1/4 Cor. Sec. 19
 Found 1/2" Rod in Hole
 in Asphalt Road

C. Description of monument for corner and accessories established to perpetuate locating the position of the corner:

A-8 W 1/4 Cor. Sec. 19
 1/2" Rod
 S8°E - 31.86' - Large Fence Post
 S78°W - 83.64' - 24" R. Oak
 N73°W - 122.09' - 40' R. Oak
 N 42°W - 46.42' - Fence Cor. Post
 North - 2' - Center Asphalt Road

Signed by Donald L. Bissell
 Surveyor's Michigan License No. 18655

Date

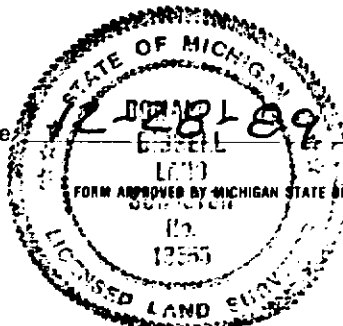

FORM APPROVED BY MICHIGAN STATE BOARD OF LAND SURVEYORS, JAN. 28, 1971
 REVISED MAY 14, 1975
 REVISED JAN., 1983