

LAND CORNER RECORDATION CERTIFICATE
Filing Requirement of Act 74, Mich. P.A. 1970

For corners in

<u>St. Joseph</u> (County)	Located In:	Corner Code:##
1. Public Land Survey	T 7S R 12W	B-6, B-7
	T R	
	T R	
	T R	
2. Property Controlling in Section	S T R	
	S T R	
3. Miscellaneous Property in Sec.	S T R	
	S T R	

Register of Deeds Stamp & File Number

4. Lot No. _____, Recorded Plat _____
 5. Private Claims _____

I, Donald L. Bissell in a field survey on October, 19 89, do hereby certify that under requirements of P.A. 74, Michigan P.A. of 1970, the corner points mentioned in lines 1 and 2 above were in conformance with regulations and rules therefore as required in the current manual of survey instructions of the United States Department of the Interior, Bureau of Land Management or by a decree of a Court of Law and/or that the corner points mentioned in lines 3, 4 and 5 above were in conformance with the rules of the Michigan Board of Land Surveyors or by a Decree of a Court of Law; established, re-established, monumented, re-monumented, recovered, found as expressed below:

NOTE: Not more than 4 corners, all in the same town and range, may be recorded on this certificate.

A	B	C	D	E	F	G	H	I	J	K	L	M
2	6	5	4	3	2	1						
3												
4	7	8	9	10	11	12						
5												
6	18	17	16	15	14	13						
7	19	20	21	22	23	24						
8												
9												
10	30	29	28	27	26	25						
11												
12	31	32	33	34	35	36						
13												

A. Description of original monument and accessories and/or subsequent restoration:

B. Description of corner evidence found and/or method applied in restoring or reestablishing corner:

B-6 Center Section 18
 Found 1 1/2" Pipe


B-7 S 1/4 Cor. Sec. 18
 Found 3/4" Pipe 14' North of Stone with Chisled "X".
 3/4" Pipe fits distance from center Section from 1888 survey by G. H. Todd by Comparing distances to W 1/4 Cor. and N 1/4 Cor., Also found Stump of Original witness tree at N 1/4 Corner.

C. Description of monument for corner and accessories established to perpetuate locating the position of the corner:

B-6 Center Section 18
 1 1/2" Pipe
 S69°W - 23.14' - 10" Maple
 N63°W - 54.50' - 24" B. Oak
 N30°W - 5.43' - 13" B. Oak
 N7°W - 77.72' - 8" B. Gum
 East - 20' - Center Road
 Spike & Tag in Trees

B-7 S 1/4 Cor. Sec. 18
 3/4" Pipe
 South - 14' - Stone
 S67°E - 33.53' - 18" Hickory
 S30°E - 42.57' - 10" W. Oak
 S77°W - 23.30' - Twin 12" & 15" Cherry
 N12°W - 49.88' - 12" Hickory
 Spike and Tappin Trees

Signed by Donald L. Bissell
 Surveyor's Michigan License No. 18655

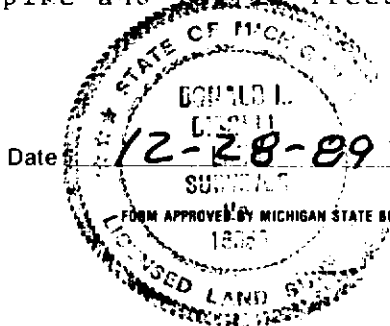

REVISÉD MAY 14, 1975
 REVISÉD JAN., 1983