

**SURVEY & REMONUMENTATION**

**JUL 16 1998**

**SECTION**

**LAND CORNER RECORDATION CERTIFICATE**  
 Filing Requirement of Act 74, Mich. P.A. 1970 LIBER **5**

PAGE **66**

For corners in

ST. JOSEPH  
 (County)  
CONSTANTINE TWP.

Located In: Corner Code #

- |                                    |                          |       |
|------------------------------------|--------------------------|-------|
| 1. Public Land Survey              | T <u>7S</u> R <u>12W</u> | B-11  |
|                                    | T _____ R _____          | _____ |
|                                    | T _____ R _____          | _____ |
|                                    | T _____ R _____          | _____ |
| 2. Property Controlling in Section | S _____ T _____ R _____  | _____ |
|                                    | S _____ T _____ R _____  | _____ |
| 3. Miscellaneous Property in Sec.  | S _____ T _____ R _____  | _____ |
|                                    | S _____ T _____ R _____  | _____ |

STATE OF MICHIGAN  
 ST. JOSEPH COUNTY  
 FILED

11 JUN 1998 9:49:56 AM

CYNTHIA L. JARRATT  
 REGISTER OF DEEDS

Register of Deeds Stamp & File Number

4. Lot No. \_\_\_\_\_, Recorded Plat \_\_\_\_\_  
 5. Private Claims \_\_\_\_\_

I, WAYNE A. MOSTROM, in a field survey on MAY 9, 1998 do hereby state that under requirements of P.A. 74, Michigan P.A. of 1970, the corner points mentioned in lines 1 and 2 above were in conformance with regulations and rules therefore as required in the current manual of survey instructions of the United States Department of the Interior, Bureau of Land Management or by a decree of a Court of Law and /or that the corner points mentioned in lines 3, 4 and 5 above were in conformance with the rules of the Michigan Board of Land Surveyors or by a Decree of a Court of Law; established, re-established, monumented, recovered, found as expressed below:

NOTE: Not more than 2 corners, all in the same town and range, may be recorded on this certificate.

	A	B	C	D	E	F	G	H	I	J	K	L	M
1													
2	6		5		4		3		2		1		
3													
4	7		8		9		10		11		12		
5													
6	18		17		16		15		14		13		
7													
8	19		20		21		22		23		24		
9													
10	30		29		28		27		26		25		
11													
12	31		32		33		34		35		36		
13													

A. Description of original monument and accessories and/or subsequent restoration:

<u>1907 SURVEY IN B/366</u>	<u>ROAD COMM. 1960'S</u>	<u>PIERCE SURVEY (1970'S)</u>
18" BLK. WAL. = S17°E 54 LKS	STL. A.P. = WEST 28.15'	FD. STA. IN MON. BOX
(35.64')	13" WAL. = N41°E 39.1'	
STONE	16" MAPLE = N69°E 26.7'	
	LONG NARROW STONE IN MON. BOX	


B. Description of corner evidence found and/or method applied in restoring or reestablishing corner:

FD. +ID STO. IN MON. BOX IN PROJ. OF FENCE LINE TO WEST  
 CL ASPHALT RDWY = EAST 0.5'  
 NONE OF THE 1960'S WITNESSES WERE STILL IN.

RATIFIED BY PEER GROUP  
 IN ACCORDANCE WITH P.A. 345  
 ON MAY 11, 1998  
Wayne CO. REPRESENTATIVE

C. Description of monument for corner and accessories established to perpetuate locating the position of the corner:

SET 5/8" X 6" IRON W/STD. CAP IN CONCRETE IN MON. BOX OVER STONE  
 N & W IN S. SIDE 8" A.P. = EAST 34.65'  
 N & W IN SW SIDE 8" FENCE POST N50°W 42.60'  
 N & W IN S. SIDE P.P. = S89°W 63.04'  
 SECURITY LIGHT POST = N40°E 55.40'

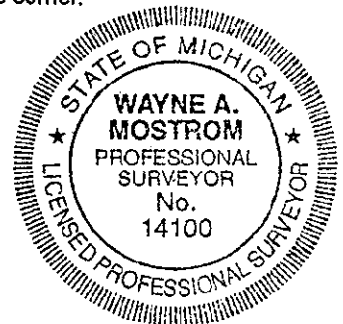

LIBER **5** PAGE **66**

Signed by Wayne A. Mostrom  
 Surveyor's Michigan License No. 14100

Date MAY 12, 1998