R

SECTION

LAND CORNER RECORDATION CERTIFICATE
Filing Requirement of Act 74, Mich. P.A. 1971

For Corners in

St. Joseph (County)	Located In:	Corner Code #
1. Public Land Survey	T 7 S R 12W	B-11
	T___ R___	
	T___ R___	Sec. 2
	T___ R___	
2. Property Controlling	S___ T___ R___	
in Section	S___ T___ R___	
3. Miscellaneous	S___ T___ R___	
Property in Sec.	S___ T___ R___	

LIBER 5 PAGE 223
STATE OF MICHIGAN
ST. JOSEPH COUNTY
FILED

22 DEC 1999 10:58:11 AM

CYNTHIA L. JARRATT
REGISTER OF DEEDS

Register of Deeds Stamp & Filing Number

4. Lot No. _____, Recorded Plat_____

5. Private Claims_____

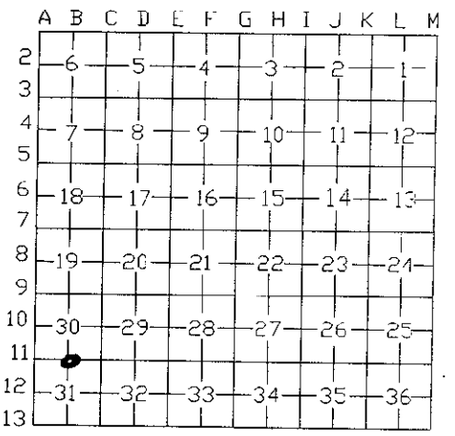

I, Donald C. Andrews, in a field survey on November, 1999, do hereby certify that under requirements of P.A. 74, Michigan P.A. of 1970, the corner points mentioned in lines 1 and 2 above were in conformance with regulations and rules therefor as required in the current manual of survey instructions of the United States Department of the Interior, Bureau of Land Management or by a decree of a Court of Law and/or that the corners mentioned in lines 3, 4 and 5 above were in conformance with the rules of the Michigan Board of Land Surveyors or by a Decree of a Court of Law; established, re-established, monument, re-monumented, recovered, found as expressed below:

NOTE: Not more than 2 corners, all in the same town and range, may be Recorded on this certificate.

A. Description of original monument and accessories and/or Subsequent restoration:

LCRC 5, PAGE 66

B. Description of corner evidence found and/or method applied in restoring or reestablishing corner:

FOUND REMON CAPPED IRON IN MON BOX.

The St. Joseph County Land Corners being located were done within specifications for Order "C 2-II". The closest the National Geodetic Reference System monument having a position order of "B" incorporated in the traverse network was the monument having the PID of "MD1335" with Station Name of "Q 122". The maximum positional error of each Land Corner monument being located would be less than 0.08 feet relative to the connecting HARN control monuments of the National Geodetic Reference System based on a 95% confidence level.

C: Description of monument for corner and accessories to perpetuate locating the position of the corner:

REMON CAPPED IRON IN MON BOX

It's coordinates in international feet are: Northing 120935.2621, Easting 12746296.5896

Witness: 8" AP East 34.65', 8" fence post N50°W 42.60', UP S89°W 63.04', security light post N40°E 55.40'

RATIFIED BY PEER GROUP
IN ACCORDANCE WITH P.A. 345
ON MAY 11, 1998
CO. REPRESENTATIVE
12/21/99

Signed by Donald C. Andrews Date 12-20-99

Surveyors Michigan License No. 33967

STATE OF MICHIGAN
DONALD C. ANDREWS
PROFESSIONAL SURVEYOR
No. 33967
LICENSED PROFESSIONAL SURVEYOR

FORM APPROVED BY MICHIGAN STATE BOARD OF LAND SURVORS, JAN. 28, 1971
REVISED MAY 14, 1975
REVISED JAN., 1983
REVISED OCT., 1995
ADAPTED FOR WORD PROCESSING

REMONUMENTATION