

**SURVEY &
REMONUMENTATION**

JUL 16 1998

SECTION

LAND CORNER RECORDATION CERTIFICATE
Filing Requirement of Act 74, Mich. P.A. 1970 LIBER **5** PAGE **68**

For corners in

ST. JOSEPH _____ Located In: _____ Corner Code # _____
(County)
CONSTANTINE TWP.
1. Public Land Survey T 7S R 12W C-11
T _____ R _____
T _____ R _____
T _____ R _____
2. Property Controlling S _____ T _____ R _____
in Section S _____ T _____ R _____
3. Miscellaneous S _____ T _____ R _____
Property in Sec. S _____ T _____ R _____

STATE OF MICHIGAN
ST. JOSEPH COUNTY
FILED

11 JUN 1998 9:50:32 AM

CYNTHIA L. JARRATT
REGISTER OF DEEDS

Register of Deeds Stamp & File Number

4. Lot No. _____, Recorded Plat _____
5. Private Claims _____

I, WAYNE A. MOSTROM, in a field survey on 5/26, 19 98 do hereby state that under requirements of P.A. 74, Michigan P.A. of 1970, the corner points mentioned in lines 1 and 2 above were in conformance with regulations and rules therefore as required in the current manual of survey instructions of the United States Department of the Interior, Bureau of Land Management or by a decree of a Court of Law and/or that the corner points mentioned in lines 3, 4 and 5 above were in conformance with the rules of the Michigan Board of Land Surveyors or by a Decree of a Court of Law; established, re-established, monumented, recovered, found as expressed below:

NOTE: Not more than 2 corners, all in the same town and range, may be recorded on this certificate.

	A	B	C	D	E	F	G	H	I	J	K	L	M
1													
2		6		5		4		3		2		1	
3													
4		7		8		9		10		11		12	
5													
6		18		17		16		15		14		13	
7													
8		19		20		21		22		23		24	
9													
10		30		29		28		27		26		25	
11													
12		31		32		33		34		35		36	
13													

A. Description of original monument and accessories and/or subsequent restoration:

<u>1907 SURVEY IN B/366</u>	<u>1963 ROAD COMMISSION</u>	<u>PIERCE SURVEY (1970'S)</u>
STONE	STONE + 'D	FOUND STONE
27" BUTTERNUT = S7°W 42 LKS	28" BASSWOOD = N80°W 16.8'	<u>MOSTROM SURVEY 1983</u>
6" SOFT MAPLE = N88½°W X	15" MAPLE = S10°E 45'	FOUND STONE
		8" TREE = N80°W 7.37'
		15" TREE = S50°W 20.75'
		13" TREE = S10°W 53.11'


B. Description of corner evidence found and/or method applied in restoring or reestablishing corner:

FOUND + 'D STONE @ GRADE 0.85' N. OF
R.R. TIE A.P. @ INTERSEC. OF FENCES
STUMP = N80°W 16.8'
ALL WIT'S FROM 1983 SURVEY ARE IN AND CHECK O.K.

RATIFIED BY PEER GROUP
IN ACCORDANCE WITH P.A. 345
ON June 8, 1998
Wayne CO. REPRESENTATIVE

C. Description of monument for corner and accessories established to perpetuate locating the position of the corner:

SET 5/8" X 48" IRON BAR WITH STD. CAP
N & W IN N. SIDE 18" MAPLE = N80°W 7.37'
N & W IN N'LY SIDE 25" TREE = S50°W 20.75'
N & W IN W SIDE RR TIE A.P. = EAST 3.02'
N & W IN NW SIDE 10" DBL. HICK. = N57°E 6.00'
N & W IN W SIDE 12" BASSWOOD = N15°W 21.43'

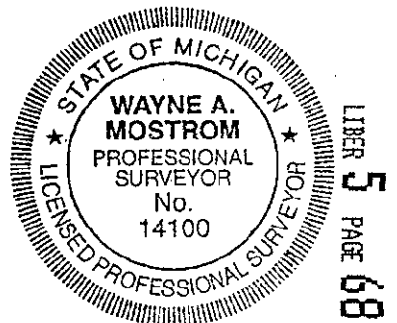

Signed by Wayne A. Mostrom WAYNE A. MOSTROM
Surveyor's Michigan License No. 14100

Date JUNE 9, 1998