

**SURVEY &  
REMONUMENTATION**

**JUL 16 1998**

**SECTION**

**LAND CORNER RECORDATION CERTIFICATE**  
Filing Requirement of Act 74, Mich. P.A. 1970

**LIBER 5 PAGE 70**

For corners in

ST. JOSEPH Located In: Corner Code #  
(County)  
CONSTANTINE TWP.  
1. Public Land Survey T7S R12W H-7  
T R  
T R  
T R  
2. Property Controlling S T R  
in Section S T R  
3. Miscellaneous S T R  
Property in Sec. S T R

STATE OF MICHIGAN  
ST. JOSEPH COUNTY  
FILED

11 JUN 1998 9:51:42 AM

CYNTHIA L. JARRATT  
REGISTER OF DEEDS

Register of Deeds Stamp & File Number

4. Lot No. \_\_\_\_\_, Recorded Plat \_\_\_\_\_  
5. Private Claims \_\_\_\_\_

I, WAYNE A. MOSTROM, in a field survey on MAY 11, 1998 do hereby state that under requirements of P.A. 74, Michigan P.A. of 1970, the corner points mentioned in lines 1 and 2 above were in conformance with regulations and rules therefore as required in the current manual of survey instructions of the United States Department of the Interior, Bureau of Land Management or by a decree of a Court of Law and /or that the corner points mentioned in lines 3, 4 and 5 above were in conformance with the rules of the Michigan Board of Land Surveyors or by a Decree of a Court of Law; established, re-established, monumented, recovered, found as expressed below:

NOTE: Not more than 2 corners, all in the same town and range, may be recorded on this certificate.

	A	B	C	D	E	F	G	H	I	J	K	L	M
1													
2	6		5		4		3		2		1		
3													
4	7		8		9		10		11		12		
5													
6	10		17		16		15		14		13		
7													
8	19		20		21		22		23		24		
9													
10	30		29		28		27		26		25		
11													
12	31		32		33		34		35		36		
13													

**A. Description of original monument and accessories and/or subsequent restoration:**

<u>ROAD COMMISSION - 1960'S</u>	<u>SAYERS 1972 SURVEY</u>
STONE UNDER MON. BOX	MON. BOX 2611.24'
A.P. = N2°W 31.35'	W. OF SE COR. SEC.
23" OAK = N18°E 37.2'	<u>1976 LCRC IN 3/136</u>
23" MAPLE = S39°W 31.4'	STONE IN MON. BOX
	24" OAK = N16°E 36.15'
	P.P. = SOUTH 26.65'
	24" OAK = S51°W 44.50'

1977 SURVEY BY MOSTROM  
SAME WITNESSES AS L.C.R.C.


**B. Description of corner evidence found and/or method applied in restoring or reestablishing corner:**

FOUND MON. BOX OVER 3/4" X 12" PIPE OVER STONE IN FENCE PROJ. FROM NORTH  
CL ASPHALT ROADWAY = NORTH 0.8'  
A.P. = N2°W 31.35'  
23" OAK = N18°E 37.2'  
23" MAPLE = S39°W 31.4'  
24" OAK = N16°E 36.15'  
P.P. = SOUTH 26.65'  
24" OAK = S51°W 44.5'

RATIFIED BY PEER GROUP  
IN ACCORDANCE WITH P.A. 345  
ON MAY 11, 1998  
Wayne CO. REPRESENTATIVE

**C. Description of monument for corner and accessories established to perpetuate locating the position of the corner:**

SET 11 1/2" X 5/8" BAR W/STD. CAP OVER STONE IN MON. BOX  
N & W IN E. SIDE 30" OAK = N18°E 37.20'  
N & W IN W. SIDE P.P. = SOUTH 26.65'  
N & W IN NW SIDE 36" OAK = S51°W 44.50'  
N & W IN E. SIDE P.P. = N2°W 32.80'  
SE COR. HOUSE = N20°W 130.12'

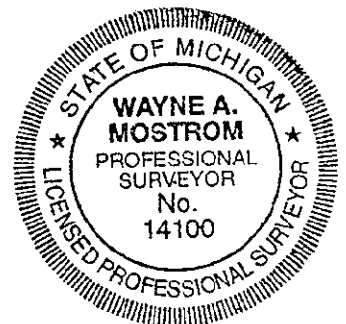

LIBER 5 PAGE 70

Signed by Wayne A. Mostrom  
Surveyor's Michigan License No. 14100

Date MAY 12, 1998