

SURVEY & REMONUMENTATION

MAY 05 1995

COMMISSION

LAND CORNER RECORDATION CERTIFICATE
 Filing Requirement of Act 74, Mich. P.A. 1970 **LIBER 4 PAGE 127**

For corners in

<u>ST. JOSEPH</u> (County)	Located In:	Corner Code #
BURR OAK TWP.	T <u>7S</u> R <u>9W</u>	<u>D-3</u>
1. Public Land Survey	T _____ R _____	_____
	T _____ R _____	_____
	T _____ R _____	_____
	T _____ R _____	_____
2. Property Controlling In Section	S _____ T _____ R _____	_____
	S _____ T _____ R _____	_____
3. Miscellaneous Property in Sec.	S _____ T _____ R _____	_____
	S _____ T _____ R _____	_____
4. Lot No. _____, Recorded Plat _____		
5. Private Claims _____		

STATE OF MICHIGAN
 ST. JOSEPH COUNTY
 FILED

12 APR 95 3:16 P.M.

CYNTHIA JARRATT
 REGISTER OF DEEDS

Register of Deeds Stamp & File Number

I, DAVID W. MOSTROM in a field survey on MARCH 28, 19 95, do hereby certify that under requirements of P.A. 74, Michigan P.A. of 1970, the corner points mentioned in lines 1 and 2 above were in conformance with regulations and rules therefore as required in the current manual of survey instructions of the United States Department of the Interior, Bureau of Land Management or by a decree of a Court of Law and/or that the corner points mentioned in lines 3, 4 and 5 above were in conformance with the rules of the Michigan Board of Land Surveyors or by a Decree of a Court of Law; established, re-established, monumented, re-monumented, recovered, found as expressed below:

	A	B	C	D	E	F	G	H	I	J	K	L	M
2	6		5		4		3		2		1		
3				●									
4	7		8		9		10		11		12		
5													
6	18		17		16		15		14		13		
7													
8	19		20		21		22		23		24		
9													
10	30		29		28		27		26		25		
11													
12	31		32		33		34		35		36		
13													

NOTE: Not more than 4 corners, all in the same town and range, may be recorded on this certificate.

A. Description of original monument and accessories and/or subsequent restoration:

(D-3) NORTH 1/4 COR. SEC. 8

GLO

1870 SURVEY IN BOOK A, PG. 168

18" W. OAK = S13°E 27.72'
 14" W. OAK = N31°E 9.9'

SET STAKE FROM OLD BRG. STUMP
 NO WITNESSES GIVEN

B. Description of corner evidence found and/or method applied in restoring or reestablishing corner:

(D-3)


FOUND 7" X 7' X 14" TANNISH LIMESTONE AT SOUTH SIDE OF ANCHOR POST WITH FENCES RUNNING NORTH & WEST

RATIFIED BY PEER GROUP
 IN ACCORDANCE WITH P.A. 345
 ON April 10, 1995
Wass CO. REPRESENTATIVE

C. Description of monument for corner and accessories established to perpetuate locating the position of the corner:

(D-E) NORTH 1/4 COR. SEC. 8

LOWERED STONE & SET 5/8" X 24" IRON BAR W/STD. CAP OVER IT
 N & W 0.5' HIGH IN W. SIDE OF ANCHOR POST = NORTH 0.71'
 N & W 0.7' HIGH IN W. SIDE OF 6" SASSAFRAS = S20°E 2.53'
 N & W 1.0' HIGH IN N. SIDE OF 8" CHERRY = S65°W 6.36'
 N & W 1.5' HIGH IN S. SIDE OF 30' OAK = N84°W 30.18'
 N & W 1.5' HIGH IN N. SIDE OF 14" POPLAR = S83°E 70.85'

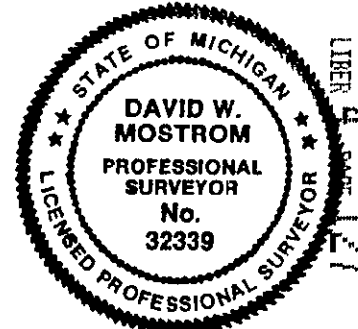

Signed by J. W. Mostrom Date APRIL 11, 1995
 Surveyor's Michigan License No. 32339