

**SURVEY & REMONUMENTATION**

MAY 05 1995

COMMISSION

**LAND CORNER RECORDATION CERTIFICATE**

Filing Requirement of Act 74, Mich. P.A. 1970 LIBER 4 PAGE 124

For corners in

<u>ST. JOSEPH</u> (County)	Located In:	Corner Code #/
BURR OAK TWP.		
1. Public Land Survey	T <u>7S</u> R <u>9W</u>	<u>D-4</u>
	T _____ R _____	_____
	T _____ R _____	_____
	T _____ R _____	_____
2. Property Controlling in Section	S _____ T _____ R _____	_____
	S _____ T _____ R _____	_____
3. Miscellaneous Property in Sec.	S _____ T _____ R _____	_____
	S _____ T _____ R _____	_____
4. Lot No. _____, Recorded Plat _____		
5. Private Claims _____		

STATE OF MICHIGAN  
ST. JOSEPH COUNTY  
FILED

12 APR 95 3:16 P.M.

CYNTHIA JARRAIT  
REGISTER OF DEEDS

Register of Deeds Stamp & File Number

	A	B	C	D	E	F	G	H	I	J	K	L	M
2	6		5		4		3		2		1		
3													
4	7		8		9		10		11		12		
5													
6	18		17		16		15		14		13		
7													
8	19		20		21		22		23		24		
9													
10	30		29		28		27		26		25		
11													
12	31		32		33		34		35		36		
13													

I, DAVID W. MOSTROM, in a field survey on OCTOBER 3, 19 94, do hereby certify that under requirements of P.A. 74, Michigan P.A. of 1970, the corner points mentioned in lines 1 and 2 above were in conformance with regulations and rules therefore as required in the current manual of survey instructions of the United States Department of the Interior, Bureau of Land Management or by a decree of a Court of Law and/or that the corner points mentioned in lines 3, 4 and 5 above were in conformance with the rules of the Michigan Board of Land Surveyors or by a Decree of a Court of Law; established, re-established, monumented, re-monumented, recovered, found as expressed below:

**NOTE: Not more than 4 corners, all in the same town and range, may be recorded on this certificate.**

A. Description of original monument and accessories and/or subsequent restoration:

(D-4) CENTER SEC. 8

1870 SURVEY IN BOOK A, PG. 168

STAKE SET AT INT. OF 1/4 LINES  
NO WITNESSES

1975 MOSTROM SURVEY & LCRC IN BOOK 2, PG. 27

POINT STONE IN MON. BOX  
PK IN RR TIE = SOUTH 30.83'  
NAIL & CAP = NORTH 27.03'  
36" MAPLE = S70°E 72.75'

B. Description of corner evidence found and/or method applied in restoring or reestablishing corner:

(D-4)


FOUND POINTED STONE IN MON. BOX  
48" MAPLE = S70°E 74.20'  
R.R. TIE ANCHOR POST = NORTH 27.30'  
CORNER FALLS IN CL OF E-W ROAD AND  
IN LINE WITH FENCES NORTH & SOUTH

RATIFIED BY PEER GROUP  
IN ACCORDANCE WITH P.A. 345  
ON April 10, 19 95  
[Signature] CO. REPRESENTATIVE

C. Description of monument for corner and accessories established to perpetuate locating the position of the corner:

(D-4) CENTER SEC. 8

SET 5/8" X 24" IRON BAR W/STD. CAP IN MON. BOX  
5/8" IRON BAR = N39°W 48.83'  
SE HSE. COR. = N67°W 150.70'  
IRON ANCHOR POST = SOUTH 30.70'  
N & W 2' HIGH ON W. SIDE OF R.R. TIE ANCHOR POST = NORTH 27.30'  
N & W 2' HIGH ON N. SIDE OF 48" MAPLE = S70°E 74.20'

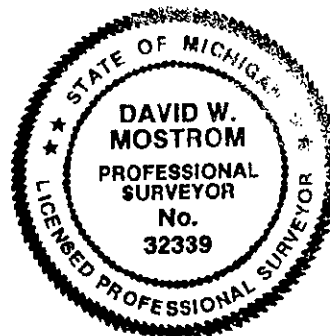

Signed by

[Signature]

Date APRIL 11, 1995

Surveyor's Michigan License No. 32339

LIBER 4 PAGE 124