

**LAND CORNER RECORDATION CERTIFICATE**  
 Filing Requirement of Act 74, Mich. P.A. 1971

For Corners in

<u>ST. JOSEPH</u> (County)	Located In:	Corner Code #
1. Public Land Survey	T <u>7S</u> R <u>9W</u>	<u>E-11</u>
	T ___ R ___	_____
	T ___ R ___	_____
	T ___ R ___	_____
2. Property Controlling	S ___ T ___ R ___	_____
in Section	S ___ T ___ R ___	<u>JAN 31 2001</u>
3. Miscellaneous	S ___ T ___ R ___	_____
Property in Sec.	S ___ T ___ R ___	<u>SECTION</u>
4. Lot No. _____	Recorded Plat _____	
5. Private Claims _____		

**LIBER 6 PAGE 43**  
 STATE OF MICHIGAN  
 ST. JOSEPH COUNTY  
 FILED

6 JUN 2000 10:14:18 AM

CYNTHIA L. JARRATT  
 REGISTER OF DEEDS

Register of Deeds Stamp & Filing Number

I, DONALD C. ANDREWS, in a field survey on APRIL 18, 2000, do hereby certify that under requirements of P.A. 74, Michigan P.A. of 1970, the corner points mentioned in lines 1 and 2 above were in conformance with regulations and rules therefor as required in the current manual of survey instructions of the United States Department of the Interior, Bureau of Land Management or by a decree of a Court of Law and/or that the corners mentioned in lines 3, 4 and 5 above were in conformance with the rules of the Michigan Board of Land Surveyors or by a Decree of a Court of Law; established, re-established, monument, re-monumented, recovered, found as expressed below:

**NOTE: Not more than 2 corners, all in the same town and range, may be Recorded on this certificate.**

A. Description of original monument and accessories and/or Subsequent restoration:

- GLO POST 16" W. OAK N573/4"W 197.34', 16" Y. OAK N17°E 242.22'
- 1944 MURRAY'S NOTES FOUND STONE, 20" BLACK OAK SE 34.3', 40" STUMP NW 36', 20" B. OAK NE 52.7' (TO FACE)
- 1956 CO. ROAD COM. BLUE STONE X'D UNDER MON. BOX 36" OAK N45°E 53.3', 25" OAK S50°E 35.5', 21" OAK N28°W 87.6'
- 1956 SAYERS NOTES STONE UNDER MON BOX, 36" OAK N45°E 53.3', 25" OAK S50°E 35.5', 21" OAK N28°W 87.6'
- LCRC 3 PAGE 101 DATED 9/7/90 3/4" IRON BAR, 30" OAK SW 42.8', 36" OAK SE 34.3', 36" OAK NE 52.7'
- 1976 SAYRES SURVEY FOUND 3/4" BAR

- 1981 SAYERS SURVEY 3/4" BAR 30" OAK SW 42.8', 36" OAK SE 34.3', 36" OAK NE 52.7'
- 1992 MOSTROM SURVEY FOUND AXLE SHAFT 34" OAK S50°W 42.8', 40" OAK S60°E 34.3', 40" OAK N45°E 52.7', R.R TIE POST S10°E 20.35'
- 1994 MOSTROM SURVEY 1" PIPE OVER 'd STONE IN MON BOX 48" OAK N45°E 53.3', 48" OAK S50°E 35.5', 50" OAK N28°W 87.6', 42" OAK S50°W 44'
- 1995 MOSTROM SURVEY 1" PIPE OVER 'd STONE IN MON BOX 48" OAK N45°E 53.3', 48" OAK S50°E 35.5', 50" OAK N28°W 87.6', 42" OAK S50°W 44'

B. Description of corner evidence found and/or method applied in restoring or reestablishing corner:


FOUND 1" X 1.1' IRON ROD OVER 'd STONE DOWN 1.2'  
 42" OAK S45°E 35.47'  
 42" OAK S65°W 44.02'  
 48" OAK N14°W 87.63'  
 45" OAK N50°E 53.45'

LOCATED 2' WEST OF C. LINE CARPENTERSON RD. AND 1.75' SOUTH OF C. LINE WITT LAKE RD.

C. Description of monument for corner and accessories to perpetuate locating the position of the corner:

SET 5/8" X 8" CAPPED IRON IN CONCRETE OVER STONE IN MON. BOX  
 42" OAK S45°E 35.47'  
 42" OAK S65°W 44.02'  
 48" OAK N14°W 87.63'  
 45" OAK N50°E 53.45'

RATIFIED BY PEER GROUP  
 IN ACCORDANCE WITH P.A. 345  
 ON April 10, 2000  
 \_\_\_\_\_ CO. REPRESENTATIVE

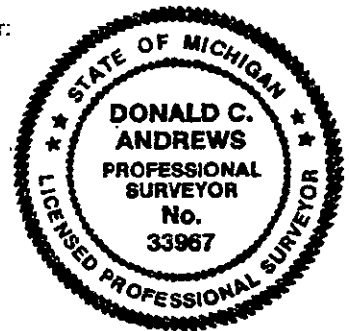

Signed by Donald C. Andrews Date 4-19-00

Surveyors Michigan License No. 33967

FORM APPROVED BY MICHIGAN STATE BOARD OF LAND SURVORS, JAN. 28, 1971  
 REVISED MAY 14, 1975  
 REVISED JAN., 1983  
 REVISED OCT., 1995  
 ADAPTED FOR WORD PROCESSING

**REMONUMENTATION**

A	B	C	D	E	F	G	H	I	J	K	L	M
2	6	5	4	3	2	1						
3												
4	7	8	9	10	11	12						
5												
6	18	17	16	15	14	13						
7												
8	19	20	21	22	23	24						
9												
10	30	29	28	27	26	25						
11												
12	31	32	33	34	35	36						
13												

LIBER 6 PAGE 43