

NOV 04 1997

COMMON

LAND CORNER RECORDATION CERTIFICATE  
Filing Requirement of Act 74, Mich. P.A. 1970

LIBER 5 PAGE 7

For corners in St. Joseph Located In:                      Corner Code #                       
(County)

1. Public Land Survey T 7S R 9W F-13                       
T        R                              
T        R                              
T        R                            

2. Property Controlling S        T        R                              
in Section S        T        R                            

3. Miscellaneous S        T        R                              
Property in Sec. S        T        R                            

4. Lot No.                     , Recorded Plat                     

5. Private Claims                     

STATE OF MICHIGAN  
ST. JOSEPH COUNTY  
FILED

7 AUG 97 3:49 P.M.

CYNTHIA JARRATT  
REGISTER OF DEEDS

Register of Deeds Stamp & File Number

I, Donald C. Andrews, in a field survey on December 9, 1996 do hereby certify that under requirements of P.A. of 1970, the corner points mentioned in lines 1 and 2 above were in conformance with regulations and rules therefore as required in the current manual of survey instructions of the United States Department of the Interior, Bureau of Land Management or by a decree of a Court of Law and/or that the corner points mentioned in lines 3, 4 and 5 above were in conformance with the rules of the Michigan Board of Land Surveyors or a Decree of a Court of Law; established, re-established, monumented, re-monumented, recovered, found as expressed below:

	A	B	C	D	E	F	G	H	I	J	K	L	M
2	6	5	4	3	2	1							
3													
4	7	8	9	10	11	12							
5													
6	18	17	16	15	14	13							
7													
8	19	20	21	22	23	24							
9													
10	30	29	28	27	26	25							
11													
12	31	32	33	34	35	36							
13													

NOTE: Not more than 4 corners, all in the same town and range, may be recorded on this certificate.

A. Description of original monument and accessories and/or subsequent restoration:  
F-1  
GLO Post  
1901 Bk B, P 59, Co. Surveyor Todd Rail & Brick during survey, Todd set several corners along the South line of the section.

Co. Rd. Records show that they re established from adjacent corners. Bruce Jones, Co. Rd. Engineer, said that he searched area with motor grader and did not find anything at corner. He had found several corners along the town line which agreed with the record.

1980 - Mostrom found 3/4" pipe in mon box. P. Pole S48°W 40.65', TBox

B. Description of corner evidence found and/or method applied in restoring or reestablishing corner:

F-1 found 1/2" pipe x 36". Removed Box & dub down 44" below surface. Still only road gravel found. Approved by Peer group as best evidence 11/11/96. Reset found pipe with 5/8"x24" iron in mon box


RATIFIED BY PEER GROUP  
IN ACCORDANCE WITH P.A. 345  
ON Nov. 14, 1996  
Wren CO. REPRESENTATIVE  
(Common Cor. with F-1 of 8-9)

C. Description of monument for corner and accessories established to perpetuate locating the position of the corner:

F-1 alum capped 5/8"x24 iron in mon box: 1)P.Pole S45°W 40.99', 2) Set Cap. Iron (SCI#33967) S20°W 62.97', 3) SCI#33967 S20°E 48.17', 4) SCI#33967 N70°E 75.03'

LIBER 5 PAGE 7

Signed by Donald C. Andrews  
Donald C. Andrews, P.S.  
Surveyor's Michigan License No. 33967

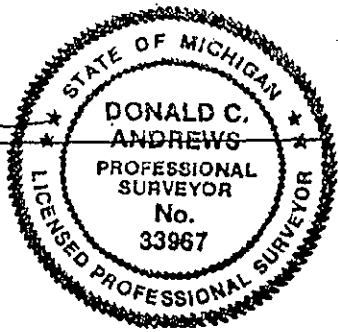

Date 12-10-96