

REMOVED

NOV 04 1997

LAND CORNER RECORDATION CERTIFICATE
Filing Requirement of Act 74, Mich. P.A. 1970

LIBER 5 PAGE 8

For corners in St. Joseph (County) Located In: Corner Code #
1. Public Land Survey T 7S R 9W G-13
2. Property Controlling in Section S T R
3. Miscellaneous Property in Sec. S T R
4. Lot No. Recorded Plat
5. Private Claims

STATE OF MICHIGAN
ST. JOSEPH COUNTY
FILED
7 AUG 97 3:49 P.M.
CYNTHIA JARRATT
REGISTER OF DEEDS
Register of Deeds Stamp & File Number

I, Donald C. Andrews, in a field survey on December 9, 1996, do hereby certify that under requirements of P.A. of 1970, the corner points mentioned in lines 1 and 2 above were in conformance with regulations and rules therefore as required in the current manual of survey instructions of the United States Department of the Interior, Bureau of Land Management or by a decree of a Court of Law and/or that the corner points mentioned in lines 3, 4 and 5 above were in conformance with the rules of the Michigan Board of Land Surveyors or a Decree of a Court of Law; established, re-established, monumented, re-monumented, recovered, found as expressed below:

NOTE: Not more than 4 corners, all in the same town and range, may be recorded on this certificate.

A. Description of original monument and accessories and/or subsequent restoration:

G-1 GLO Post
1871 Bk A, P. 176 - Co. Surveyor Rose - on line with quarter stakes North and South.
1901 Bk B, P. 59 - Co. Surveyor Todd - established using the stump of a original wit. tree found remains of original rotted post. Set oak stake 3"x48" surrounded with brick.
1964 Co. Rd. Records angle iron under wood stake
LCRC 3, P. 140 pipe @ rd. PI 9.91' west of corner
various other surveys used corner as shown in LCRC 3, P. 140
1991 - Mostrom survey found 1/2" iron Mulberry tree S 2.98', 28" trip Elm E 9.23', Pipe W 9.91'

Grid table with columns A-M and rows 2-13. Contains numbers 1-36 in a grid pattern.

B. Description of corner evidence found and/or method applied in restoring or reestablishing corner:


G-1
Found 1/2" iron at surface. below iron found 24" long angle iron 6 inches below surface surround with newer brick. removed angle iron and dug to below original grade (42 inches). Found colum of brick. The deeper I went the older the brick was. Brick disappeared at a depth of ±42 inches. Reset corner with 5/8" x24" iron surround with brick.

RATIFIED BY PEER GROUP
IN ACCORDANCE WITH P.A. 345
ON Nov. 14, 1996
Warr CO. REPRESENTATIVE
(Common Cor. with G-1 of B-9)

C. Description of monument for corner and accessories established to perpetuate locating the position of the corner:

G-1
alum capped 5/8"x24" iron surround with brick: 1) 1" Ash S85°E 30.50', 2) 8" Mulberry (Cut off) South 2.97', 3) 10" Ash N30°W 4.5', 4) 18" Elm 20.35' N10°E

Signed by Donald C. Andrews, P.S.
Surveyor's Michigan License No. 33967

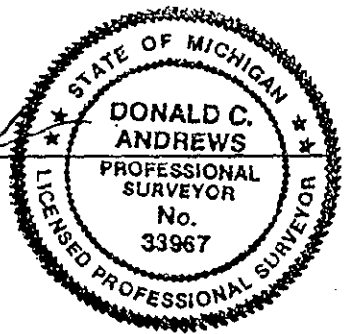

Date 12-10-96

LIBER 5 PAGE 8