LIBER 4 PAGE 71

- 01D,	Requirement of Act 74, Mich. P.A. 1970	
ST. JOSEPH APR AND Cocated in:	Corner Code =##	STATE OF MICHIGAN ST. JOSEPH COUNTY
COM		FILED

AND CODNED DECODDATION CERTIFICATE

Public Land Survey T 7S R 9W ____ R ____ __ R __ ____ R ____

TY

6 DEC 94 4:30 P.H.

CYNTHIA JARRATT REGISTER OF DEEDS


Register of Deeds Stamp & File Number

2. Property Controlling T ... R in Section ___ T ____ R ____ Miscellaneous __ T .____ R ____ R Property in Sec.


___ , Recorded Plat _____

Private Claims

2.5 , 19 <u>9</u>4 . I, WAYNE A. MOSTROM in a field survey on . do hereby certify that under requirements of P.A. 74, Michigan P.A. of 1970, the corner points mentioned in lines 1 and 2 above were in conformance with regulations and rules therefore as required in the current manual of survey instructions of the United States Department of the interior, Burcau of Land Management or by a decree of a Court of Law and/or that the corner points mentioned in lines 3, 4 and 5 above were in conformance with the rules of the Michigan Board of Land Surveyors or by a Decree of a Court of Law; established, re-established, monumented, re-monumented, recovered, found as

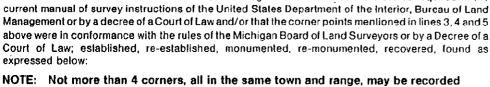

on this certificate.

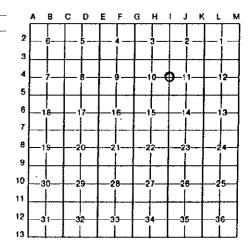

A. Description of original monument and accessories and/or subsequent restoration:

1873 SURVEY BY GARDNER (A/202) ROAD COMMISSION - 1960'S

SET STONE FROM ORIG. BEARING TREE, NOW GREEN

POINTED STD./MON. BOX

28"MAP. = N65°W 64.5" 27'MAP. = \$68°W 68.5' 1976 L.C.R.C. - 3/97 1978 SURVEY

FD. STD. IN MON. BO X FD. STD. IN CONC. A.P. = N47°E 40.8' P.P. = SW 71.0'

28" MAP. = NW 63.2" 10" MAP. = 48.7"

COR IS IN CL RDWY'S

MON. BOX P.P. = \$20°W

71.61' TELE. POLE =

B. Description of corner evidence found and/or method applied in restoring or reestablishing corner:

\$30°E 56.751 TELE. POLE = N43°E 42.41'

P.P. = SW 71.0DEPRESSION FROM OLD TREE = NW 63.2' 10" MAP. = NE 48.7' COR. IS IN CL OF RDWY'S FD. STONE IN MON. BOX NAIL IN POLE = \$20°W 71.76° TELE. POLE = \$30°E 56.75'

RATIFIED BY PEER GROUP IN ACCORDANCE WITH P.A. 345 ON AUGUST B , 1994 CO. REPRESENTATIVE

C. Description of monument for corner and accessories established to perpetuate locating the position of the corner:

1-4 - (1/4 COR. BETWEEN SEC'S 10-11)

SET 5/8"X7" BAR & STD. CAP IN CONC. OVER STD. IN MON. BOX NE COR. HSE = S45°W 115.34'

SE COR. HSE. = N38°W 120.13'

N & W IN NW SIDE POWER POLE = S25°W 71.621 N &W IN W. SIDE BRACE POLEM = S25°E 56.821

COR. IS IN CL ASPHALT RDWY'S TO E. & N.

14100 Surveyor's Michigan License No. _

OF MICHIGA WAYNE MOSTROM PROFESSIONAL SURVEYOR No. 14100 POFESSION

FORM APPROVED BY MICHIGAN STATE BOARD OF LAND SURVEYORS, JAN. 28, 1971

REVISED JAN., 1983

REMONUMENTATION