

SURVEY & REMONUMENTATION

JAN 22 1999

SECTION

LAND CORNER RECORDATION CERTIFICATE
Filing Requirement of Act 74, Mich. P.A. 1971

For Corners in

LIBER 5 PAGE 110

ST. JOSEPH (County)

1. Public Land Survey Located In: T 7S R 9W Corner Code # J-1

2. Property Controlling S T R in Section S T R

3. Miscellaneous S T R Property in Sec. S T R

4. Lot No. Recorded Plat

5. Private Claims

STATE OF MICHIGAN
ST. JOSEPH COUNTY
FILED

15 DEC 1998 11:15:32 AM

CYNTHIA L. JARRATT
REGISTER OF DEEDS

Register of Deeds Stamp & Filing Number

	A	B	C	D	E	F	G	H	I	J	K	L	M
2	6	5	4	3	2	1							
3													
4	7	8	9	10	11	12							
5													
6	18	17	16	15	14	13							
7													
8	19	20	21	22	23	24							
9													
10	30	29	28	27	26	25							
11													
12	31	32	33	34	35	36							
13													

I, DONALD C. ANDREWS, in a field survey on JUNE 3, 1998, do hereby certify that under requirements of P.A. 74, Michigan P.A. of 1970, the corner points mentioned in lines 1 and 2 above were in conformance with regulations and rules therefor as required in the current manual of survey instructions of the United States Department of the Interior, Bureau of Land Management or by a decree of a Court of Law and/or that the corners mentioned in lines 3, 4 and 5 above were in conformance with the rules of the Michigan Board of Land Surveyors or by a Decree of a Court of Law; established, re-established, monument, re-monumented, recovered, found as expressed below:

NOTE: Not more than 2 corners, all in the same town and range, may be Recorded on this certificate.

A. Description of original monument and accessories and/or Subsequent restoration:

CO. SURVEYOR'S RECORD 1867 BOOK A, P. 158 GARDNER SET STAKE MIDWAY BETWEEN (I-1) AND (K-1)

CO. SURVEYOR'S RECORD 1885 BOOK A, P. 475 TODD AN IRON SLEIGH SHOE FLAGED BY N. S. ANDREWS

LCRC 4, P. 203 ANDREWS "T" IRON BETWEEN TWO GUARD STONES (EAST AND WEST). "T" IRON WAS PROBABLY THE OLD SLEIGH SHOE ARE STILL IN GOOD CONDITION AND CHECK OK FOR DISTANCE

SET CAPPED IRON

B. Description of corner evidence found and/or method applied in restoring or reestablishing corner:


FOUND CAPPED IRON #33967. WITNESS FROM LCRC 4, P. 203 AGREE WITH WITNESSES SHOWN IN PART "C" BELOW.

C: Description of monument for corner and accessories to perpetuate locating the position of the corner:

SET 5/8" IRON X 24 INCHES WITH STANDARD REMON. CAP OVER STONE IN MON. BOX IN CENTERLINE OF EAST-WEST ROAD.

EYE BOLT TOP CONC POST N 33°W 30.31'
24" TWIN LINDEN N 20°W 40.28
18" WALNUT S 45°E 23.74'
24" WALNUT S 75°W 51.17'

RATIFIED BY PEER GROUP
IN ACCORDANCE WITH P.A. 345
ON June 8, 1998
CO. REPRESENTATIVE

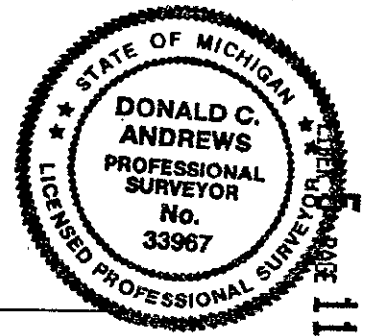

Signed by Donald C. Andrews Date 10/28/98

Surveyors Michigan License No. 33967

FORM APPROVED BY MICHIGAN STATE BOARD OF LAND SURVORS, JAN. 28, 1971
REVISED MAY 14, 1975
REVISED JAN., 1983
REVISED OCT., 1995
ADAPTED FOR WORD PROCESSING

REMONUMENTATION