

**SURVEY &
REMONUMENTATION**

JAN 22 1999

LAND CORNER RECORDATION CERTIFICATE
Filing Requirement of Act 74, Mich. P.A. 1971

SECTION

For Corners in

<u>St. Joseph Co.</u> (County)	Located In:	Corner Code #
1. Public Land Survey	T <u>7S</u> R <u>9W</u>	<u>J-5</u>
	T _____ R _____	_____
	T _____ R _____	_____
	T _____ R _____	_____
2. Property Controlling in Section	S _____ T _____ R _____	_____
	S _____ T _____ R _____	_____
3. Miscellaneous Property in Sec.	S _____ T _____ R _____	_____
	S _____ T _____ R _____	_____
4. Lot No. _____, Recorded Plat _____		
5. Private Claims _____		

LIBER 5 PAGE 114

STATE OF MICHIGAN
ST. JOSEPH COUNTY
FILED

15 DEC 1998 11:17:25 AM

CYNTHIA L. JARRATT
REGISTER OF DEEDS

Register of Deeds Stamp & Filing Number

I, Donald C. Andrews, in a field survey on October 21, 1998, do hereby certify that under requirements of P.A. 74, Michigan P.A. of 1970, the corner points mentioned in lines 1 and 2 above were in conformance with regulations and rules therefor as required in the current manual of survey instructions of the United States Department of the Interior, Bureau of Land Management or by a decree of a Court of Law and/or that the corners mentioned in lines 3, 4 and 5 above were in conformance with the rules of the Michigan Board of Land Surveyors or by a Decree of a Court of Law; established, re-established, monument, re-monumented, recovered, found as expressed below:

NOTE: Not more than 2 corners, all in the same town and range, may be Recorded on this certificate.

A. Description of original monument and accessories and/or Subsequent restoration:

Co. Road Com. Sayers No date no description

1978 Sayers survey found stone in mon. box 24" double
Hickory North 59.33', iron fence post SW 35.80'(gone)


1980 Sayers survey found mon. box/stone 26" double
Hickory North 59.33', iron fence post SW 35.8'(gone)

B. Description of corner evidence found and/or method applied in restoring or reestablishing corner:
Found pointed stone in mon. box and double Hickory North
59.3' of stone.

C: Description of monument for corner and accessories to perpetuate locating the position of the corner:
SET 5/8" X 3 INCHES IRON WITH STANDARD REMON.
CAP IN CONC. OVER STONE IN MON. BOX

SET IRON S 50°E 19.85'
SET IRON SOUTH 12.15'
SET IRON S 61° 20.49'
18" TWIN OAK N 16°W 22.92'

RATIFIED BY PEER GROUP
IN ACCORDANCE WITH P.A. 345
ON Oct. 12, 1998
Widen CO. REPRESENTATIVE

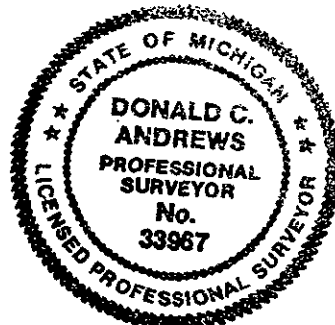

Signed by Donald C. Andrews Date 10/26/98

Surveyors Michigan License No. 33967

FORM APPROVED BY MICHIGAN STATE BOARD OF LAND SURVORS, JAN. 28, 1971
REVISED MAY 14, 1975
REVISED JAN., 1983
REVISED OCT., 1995
ADAPTED FOR WORD PROCESSING

REMONUMENTATION

	A	B	C	D	E	F	G	H	I	J	K	L	M
2	6	5	4	3	2	1							
3													
4	7	8	9	10	11	12							
5													
6	18	17	16	15	14	13							
7													
8	19	20	21	22	23	24							
9													
10	30	29	28	27	26	25							
11													
12	31	32	33	34	35	36							
13													

LIBER 5 PAGE 114