

**SURVEY &  
REMONUMENTATION**

JAN 22 1999

**LAND CORNER RECORDATION CERTIFICATE  
Filing Requirement of Act 74, Mich. P.A. 1971**

**LIBER 5 PAGE 115**

STATE OF MICHIGAN  
ST. JOSEPH COUNTY  
FILED

15 DEC 1998 11:17:47 AM

CYNTHIA L. JARRATT  
REGISTER OF DEEDS

Register of Deeds Stamp & Filing Number

**SECTION**  
For Corners in

<u>ST. JOSEPH</u> (County)	Located In:	Corner Code #
1. Public Land Survey	T <u>7S</u> R <u>9W</u>	<u>K-2</u>
	T _____ R _____	_____
	T _____ R _____	_____
	T _____ R _____	_____
2. Property Controlling	S _____ T _____ R _____	_____
in Section	S _____ T _____ R _____	_____
3. Miscellaneous	S _____ T _____ R _____	_____
Property in Sec.	S _____ T _____ R _____	_____
4. Lot No. _____, Recorded Plat _____		
5. Private Claims _____		

I, DONALD C. ANDREWS, in a field survey on JUNE 3, 1998, do hereby certify that under requirements of P.A. 74, Michigan P.A. of 1970, the corner points mentioned in lines 1 and 2 above were in conformance with regulations and rules therefor as required in the current manual of survey instructions of the United States Department of the Interior, Bureau of Land Management or by a decree of a Court of Law and/or that the corners mentioned in lines 3, 4 and 5 above were in conformance with the rules of the Michigan Board of Land Surveyors or by a Decree of a Court of Law; established, re-established, monument, re-monumented, recovered, found as expressed below:

**NOTE: Not more than 2 corners, all in the same town and range, may be Recorded on this certificate.**

A. Description of original monument and accessories and/or Subsequent restoration:

GLO POST BEARING TREES ARE GONE

CO. SURVEYOR'S RECORD BOOK A, P. 158 - 1867 GARDNER STAKE AND **STONE SET** FROM OLD BEARINGS

CO. SURVEYORS RECORD BOOK A, P. 178 - 1871 ROSE STAKE SET 40 CHAINS NORTH FROM SE COR. SEC. 2

CO. SURVEYORS RECORD BOOK A, P. 475 - 1885 TODD **STONE** PLATED BY FORMER SURVEYOR

CO. ROAD COM 1962 **FOUND LARGE STONE** UNDER 1/2" PIPE AND MONUMENT BOX

SAYERS RECORDS SHOWS **LARGE STONE** UNDER 1/2" PIPE AND MONUMENT BOX

MOSTROM 1988 SURVEY FOUND 1/2" PIPE IN MON. BOX

LCRC 4, P. 204 FOUND 1/2" PIPE MON BOX

B. Description of corner evidence found and/or method applied in restoring or reestablishing corner:


FOUND 1/2" X 13" PIPE IN MON. BOX, REMOVED PIPE AND **FOUND LARGE STONE** BELOW PIPE. ALSO DISTANCES TO WITNESS SHOWN ON LCRC 4, P. 204 AGREE WITH SAME AND DISTANCES ARE SHOWN IN PART "C" BELOW. MONUMENT BOX FOUND AT INTERSECTION OF NORTH-SOUTH ROAD AND ROAD EAST.

C. Description of monument for corner and accessories to perpetuate locating the position of the corner:

SET 5/8" IRON IN CONC. WITH STANDARD CAP OVER **LARGE STONE** IN MON. BOX

POST NEXT TO TELEPHONE BOX S 75°E 101.45'  
CONC. A.P. WEST 34.04'  
6" OAK S 50°W 43.95'  
16" OAK N 45°W 41.80'

RATIFIED BY PEER GROUP  
IN ACCORDANCE WITH P.A. 345  
ON JUNE 8, 1998  
Donald C. Andrews CO. REPRESENTATIVE

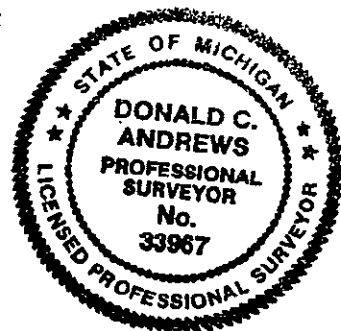

Signed by Donald C. Andrews Date 10/28/98

Surveyors Michigan License No. 33967

FORM APPROVED BY MICHIGAN STATE BOARD OF LAND SURVORS, JAN. 28, 1971

REVISED MAY 14, 1975

REVISED JAN., 1983

REVISED OCT., 1995

ADAPTED FOR WORD PROCESSING

**REMONUMENTATION**

LIBER 5 PAGE 115