

**LAND CORNER RECORDATION CERTIFICATE**  
**Filing Requirement of Act 74, Mich. P.A. 1971**

For Corners in

<u>ST. JOSEPH</u> (County)	Located In:	Corner Code #
1. Public Land Survey	T <u>7S</u> R <u>9W</u>	<u>K-5</u>
	T _____ R _____	_____
	T _____ R _____	_____
	T _____ R _____	_____
2. Property Controlling	S _____ T _____ R _____	<b>SURVEY &amp; REMONUMENTATION</b>
in Section	S _____ T _____ R _____	<b>JAN 31 2001</b>
3. Miscellaneous	S _____ T _____ R _____	_____
Property in Sec.	S _____ T _____ R _____	<b>SECTION</b>
4. Lot No. _____,	Recorded Plat _____	
5. Private Claims _____		

LIBER **6** PAGE **61**  
 STATE OF MICHIGAN  
 ST. JOSEPH COUNTY  
 FILED

11 AUG 2000 11:27:07 AM

CYNTHIA L. JARRATT  
 REGISTER OF DEEDS

Register of Deeds Stamp & Filing Number

I, DONALD C. ANDREWS, in a field survey on JUNE 29, 2000, do hereby certify that under requirements of P.A. 74, Michigan P.A. of 1970, the corner points mentioned in lines 1 and 2 above were in conformance with regulations and rules therefor as required in the current manual of survey instructions of the United States Department of the Interior, Bureau of Land Management or by a decree of a Court of Law and/or that the corners mentioned in lines 3, 4 and 5 above were in conformance with the rules of the Michigan Board of Land Surveyors or by a Decree of a Court of Law; established, re-established, monument, re-monumented, recovered, found as expressed below:

**NOTE: Not more than 2 corners, all in the same town and range, may be Recorded on this certificate.**

A. Description of original monument and accessories and/or Subsequent restoration:

GLO 10" BURR OAK N7°E 5.94', 7" BURR OAK S72°W 18.48'

1962 COUNTY ROAD COMMISSION ½" PIPE DRIVEN THROUGH REMAINS WOOD STAKE IN MONUMENT BOX

1978 SAYERS SURVEY FOUND ¾" PIPE IN MON BOX

1979 SAYERS NOTES MON BOX OVER ¼" PIPE WIT'S ANCHOR POST N52°E 35.96', TELE POLE N57°W 49.5, 28" MAPLE S40°W 48.2'

1994 MOSTROM NOTES FOUND ½" PIPE IN MON BOX WIT'S 22" SUGAR MAPLE S65°E 65.07', ANC POST N57°E 36.36', 28" SUGAR MAPLE N50°E 42.34', 30" SUGAR MAPLE N21°W 71.36', 26" SUGAR MAPLE S43°W 48.02'

B. Description of corner evidence found and/or method applied in restoring or reestablishing corner:

FOUND 1" PIPE X 3' LONG DUG 1.5' WIDE X 4' DEEP HOLE NO WOOD FIBERS FOUND

FOUND MON BOX IN CENTERLINE OF BURR OAK AND KIBILOSKI ROADS

POST N60°E 36.36' 36" MAPLE N15°W 71.36'  
 30" MAPLE S40°W 48.00' 28" MAPLE S60°E 65.1'


28" MAPLE S80°E 65.1'

C. Description of monument for corner and accessories to perpetuate locating the position of the corner:

SET 5/8" X 24" CAPPED IRON IN MON BOX

30" MAPLE S40°W 48.00' 36" MAPLE N15°W 71.36'  
 POST N60°E 36.36' 28" MAPLE S60°E 65.1'

RATIFIED BY PEER GROUP  
 IN ACCORDANCE WITH P.A. 345  
 ON JULY 10, 2000  
Wain CO. REPRESENTATIVE

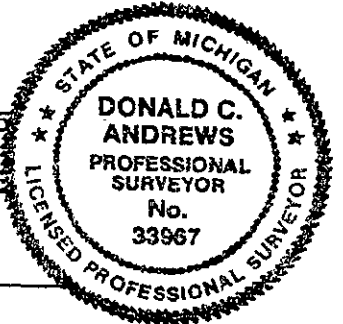

Signed by Donald C. Andrews Date 7-27-00

Surveyors Michigan License No. 33967

FORM APPROVED BY MICHIGAN STATE BOARD OF LAND SURVORS, JAN. 28, 1971  
 REVISED MAY 14, 1975  
 REVISED JAN., 1983  
 REVISED OCT., 1995  
 ADAPTED FOR WORD PROCESSING

**REMONUMENTATION**

LIBER 6 PAGE 61