

LAND CORNER RECORDATION CERTIFICATE
Filing Requirement of Act 74, Mich. P.A. 1971

For Corners in

<u>ST. JOSEPH</u> (County)	Located In:	Corner Code #
1. Public Land Survey	T <u>7S</u> R <u>9W</u>	<u>K-7</u>
	T _____ R _____	
	T _____ R _____	
	T _____ R _____	
2. Property Controlling	S _____ T _____ R _____	
in Section	S _____ T _____ R _____	SURVEY & REMONUMENTATION
3. Miscellaneous	S _____ T _____ R _____	JAN 31 2001
Property in Sec.	S _____ T _____ R _____	SECTION

LIBER 6 PAGE 62
 STATE OF MICHIGAN
 ST. JOSEPH COUNTY
 FILED
 11 AUG 2000 11:27:27 AM
 CYNTHIA L. JARRATT
 REGISTER OF DEEDS

Register of Deeds Stamp & Filing Number

4. Lot No. _____, Recorded Plat _____
5. Private Claims _____

I, DONALD C. ANDREWS, in a field survey on JUNE 29, 2000, do hereby certify that under requirements of P.A. 74, Michigan P.A. of 1970, the corner points mentioned in lines 1 and 2 above were in conformance with regulations and rules therefor as required in the current manual of survey instructions of the United States Department of the Interior, Bureau of Land Management or by a decree of a Court of Law and/or that the corners mentioned in lines 3, 4 and 5 above were in conformance with the rules of the Michigan Board of Land Surveyors or by a Decree of a Court of Law; established, re-established, monument, re-monumented, recovered, found as expressed below:

	A	B	C	D	E	F	G	H	I	J	K	L	M
2	6	5	4	3	2	1							
3													
4	7	8	9	10	11	12							
5													
6	18	17	16	15	14	13							
7													
8	19	20	21	22	23	24							
9													
10	30	29	28	27	26	25							
11													
12	31	32	33	34	35	36							
13													

NOTE: Not more than 2 corners, all in the same town and range, may be Recorded on this certificate.

**RATIFIED BY PEER GROUP
 IN ACCORDANCE WITH P.A. 345
 ON JULY 10, 2000
 WILSON CO. REPRESENTATIVE**

A. Description of original monument and accessories and/or subsequent restoration

- | | |
|--|---|
| GLO POST 14" WHITE OAK N66°W 2.64', 9" WHITE OAK S43 1/3°E 13.86' | COUNTY ROAD COMMISSION NO DATE STONE UNDER MON BOX |
| 1862 ANDREWS OLD FIELD NOTES SET STONE WIT'S 12" BURR OAK TREE N62 1/4°E 51.15' | 1979 SAYERS SURVEY STONE IN MON BOX WIT'S ANCHOR POST N45°E 44.2', ANCHOR POST S45°E 49.63', 32" MAPLE S80°W 25.1' |
| BK. A PAGE 170 1871 ROSE COUNTY SURVEYOR STONE SET IN CENTER HIGHWAY BY OTHER SURVEYOR | 1980 SAYERS SURVEY WIT'S AP N45°E 44.2', AP S45°E 49.63' |
| BK. A PAGE 406 1880 TODD CO. SURVEYOR - HAD SET STONE FOR THE CORNER WIT'S 8" MAPLE N37°E 48.84', 10" MAPLE N52 1/4°W 29.37', 4" MAPLE S73°E 25.08', 3" MAPLE S26 1/2°E 66.00' | 1992 ANDREWS LCRC 3, P. 237 STONE IN MON BOX WIT'S 22" LOCUS S50°E 47.07', 8" HICK S65°E 59.9', 16" LOCUS N80°W 33.54', LIGHT POLE N45°E 39.91' |
| 1952 MILLIMAN'S ADDITION - CONC. PLAT MON 33.00' WEST | NO DATE SAYERS NOTES STONE IN MON BOX WIT'S 32" MAPLE S80°W 25.1', AP N45°E 44.2', AP S45°E 49.63' |
| 1976 MOSTROM NOTES MON BOX OVER NOTCHED STONE WIT'S RR TIE N52°E 43.7', RR TIE S46°E 49.05', ROAD SIGN N83°W 22.2' | |

B. Description of corner evidence found and/or method applied in restoring or reestablishing corner:
 FOUND MON BOX WITH 13" LONG IRON, DUG DOWN ±15" TO STONE
 CORNER IS 2.5' WEST OF CENTERLINE OF BURR OAK ROAD AND DWIGHT ROAD

FNC POST S45°E 49.65', 21" MAPLE N35°E 48.95', UP N20°W 38.94', 36" MAPLE S80°W 25.1',
 30" LOCUS N80°W 33.56', FOUND PLAT MON WEST 33.01', 14" HICKORY S60°E 59.86', 36' LOCUS S40°E 47.05'


C. Description of monument for corner and accessories to perpetuate locating the position of the corner:
 SET 5/8" X 10" CAPPED IRON IN CONCRETE IN MON. BOX
 CORNER IS 2.5' WEST OF CENTERLINE OF N-S ROAD

FNC POST S45°E 49.65', 21" MAPLE N35°E 48.95', UP N20°W 38.94', 36" MAPLE S80°W 25.1',
 30" LOCUS N80°W 33.56', FOUND PLAT MON WEST 33.01', 14" HICKORY S60°E 59.86', 36' LOCUS S40°E 47.05'

Signed by Donald C. Andrews Date 7-26-00

Surveyors Michigan License No. 33967

REMONUMENTATION

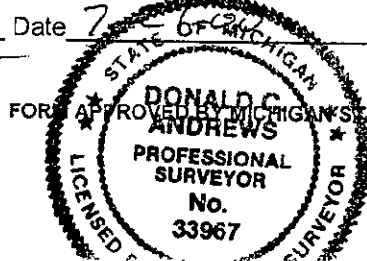

FOR APPROVED BY MICHIGAN STATE BOARD OF LAND SURVORS, JAN. 28, 1971
 REVISED MAY 14, 1975
 REVISED JAN., 1983
 REVISED OCT., 1995
 ADAPTED FOR WORD PROCESSING

LIBER 6 PAGE 62