

**LAND CORNER RECORDATION CERTIFICATE**  
**Filing Requirement of Act 74, Mich. P.A. 1971**

For Corners in SECTION

<u>St. Joseph</u> (County)	Located In:	Corner Code #
1. Public Land Survey	T <u>8S</u> R <u>9W</u>	<u>C-6</u>
	T _____ R _____	_____
	T _____ R _____	_____
	T _____ R _____	_____
2. Property Controlling in Section	S _____ T _____ R _____	_____
	S _____ T _____ R _____	_____
3. Miscellaneous Property in Sec.	S _____ T _____ R _____	_____
	S _____ T _____ R _____	_____
4. Lot No. _____, Recorded Plat _____		
5. Private Claims _____		

**LIBER 5 PAGE 224**  
 STATE OF MICHIGAN  
 ST. JOSEPH COUNTY  
 FILED

22 DEC 1999 10:58:32 AM

CYNTHIA L. JARRATT  
 REGISTER OF DEEDS

Register of Deeds Stamp & Filing Number

I, Donald C. Andrews, in a field survey on November, 1999, do hereby certify that under requirements of P.A. 74, Michigan P.A. of 1970, the corner points mentioned in lines 1 and 2 above were in conformance with regulations and rules therefor as required in the current manual of survey instructions of the United States Department of the Interior, Bureau of Land Management or by a decree of a Court of Law and/or that the corners mentioned in lines 3, 4 and 5 above were in conformance with the rules of the Michigan Board of Land Surveyors or by a Decree of a Court of Law; established, re-established, monument, re-monumented, recovered, found as expressed below:

**NOTE: Not more than 2 corners, all in the same town and range, may be Recorded on this certificate.**

A. Description of original monument and accessories and/or Subsequent restoration:

LCRC 4, PAGE 231

B. Description of corner evidence found and/or method applied in restoring or reestablishing corner:

Found Remon Capped Iron in Mon Box

The St. Joseph County Land Corners being located were done within specifications for Order "C 2-II". The closest the National Geodetic Reference System monument having a position order of "B" incorporated in the traverse network was the monument having the PID of "AA8117" with Station Name of "IRS-F". The maximum positional error of each Land Corner monument being located would be less than 0.08 feet relative to the connecting HARN control monuments of the National Geodetic Reference System based on a 95% confidence level.

C. Description of monument for corner and accessories to perpetuate locating the position of the corner:

Found Remon Capped Iron in Mon Box

It's coordinates in international feet are: Northing 101613.3795, Easting 12844474.8498

Witness: UP S28°E 52.65', NE Cor. House FTDN S78°W 95.08', UP N47°W 39.08', SE Cor. RR Rail Post N21°W 54.93'


RATIFIED BY PEER GROUP  
 IN ACCORDANCE WITH P.A. 345  
 ON JUNE 10, 1996  
Allen CO. REPRESENTATIVE

*12/21/99 Allen*

Signed by Donald C. Andrews

Date 12-20-99

Surveyors Michigan License No. 33967

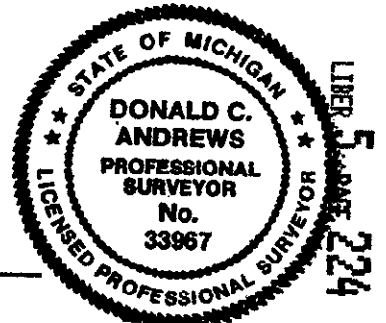

**REMONUMENTATION**