

REMOVAL

NOV 17 1997

COM

LAND CORNER RECORDATION CERTIFICATE Filing Requirement of Act 74, Mich. P.A. 1970

LIBER 5 PAGE 9

For corners in St. Joseph Located In: _____ Corner Code # _____
(County)

1. Public Land Survey T 8S R 9W E-1
T _____ R _____
T _____ R _____
T _____ R _____

2. Property Controlling S _____ T _____ R _____
in Section S _____ T _____ R _____

3. Miscellaneous S _____ T _____ R _____
Property in Sec. S _____ T _____ R _____

4. Lot No. _____, Recorded Plat _____

5. Private Claims _____

STATE OF MICHIGAN
ST. JOSEPH COUNTY
FILED

7 AUG 97 3:50 P.M.

CYNTHIA JARRATT
REGISTER OF DEEDS

Register of Deeds Stamp & File Number

I, Donald C. Andrews, in a field survey on December 9, 1996, do hereby certify that under requirements of P.A. of 1970, the corner points mentioned in lines 1 and 2 above were in conformance with regulations and rules therefore as required in the current manual of survey instructions of the United States Department of the Interior, Bureau of Land Management or by a decree of a Court of Law and/or that the corner points mentioned in lines 3, 4 and 5 above were in conformance with the rules of the Michigan Board of Land Surveyors or a Decree of a Court of Law; established, re-established, monumented, re-monumented, recovered, found as expressed below:

	A	B	C	D	E	F	G	H	I	J	K	L	M
2	6	5	4	3	2	1							
3													
4	7	8	9	10	11	2							
5													
6	18	17	16	15	14	13							
7													
8	19	20	21	22	23	24							
9													
10	30	29	28	27	26	25							
11													
12	31	32	33	34	35	36							
13													

NOTE: Not more than 4 corners, all in the same town and range, may be recorded on this certificate.


A. Description of original monument and accessories and/or subsequent restoration:
 E-1 GLO Post
 1964 Co. Rd. Records Web found Pile of stones
 1975 LCRC 3, P. 143 Pipe/Box RR tie SW 31.20'
 Oct. 1976 Doug Pierce Fd. 5/8" iron/box
 1981 LCRC 2, P. 152 3/4" pipe/box - PK in P.Pole S70°E 53.27', PK RR A.P. SW 31.30'

B. Description of corner evidence found and/or method applied in restoring or reestablishing corner:
 E-1 found 3/4" pipe x 1.2' in mon box. dug 18" dia. x 30" deep hole to below subgrade. No rocks found.
 cut off P.Pole PK nail S70°E 53.3', RR A.P. SW 31.3'
 Replaced 3/4" pipe with 5/8" x 24" iron with alum. cap

**RATIFIED BY PEER GROUP
 IN ACCORDANCE WITH P.A. 345
 ON Nov. 14, 1996
 [Signature] CO. REPRESENTATIVE
 (Common Gr. with E-13 of 7-9)**

C. Description of monument for corner and accessories established to perpetuate locating the position of the corner:
 alum. capped iron 5/8"x24" in mon box: 1) Cut off U. Pole S70°E 53.50', 2) RR A.P. S55°W 31.60', 3) P.Pole S65°W 60.99',
 4) 14" Oak S75°W 79.47'

Signed by Donald C. Andrews
 Donald C. Andrews, P.S.
 Surveyor's Michigan License No. 33967

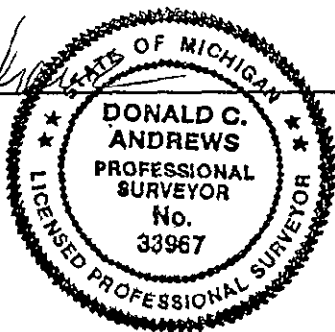

Date 12-10-96

LIBER 5 PAGE 9