

SECTION

LAND CORNER RECORDATION CERTIFICATE  
Filing Requirement of Act 74, Mich. P.A. 1971

For Corners in

<u>St. Joseph</u> (County)	Located In:	Corner Code #
1. Public Land Survey	T <u>8S</u> R <u>9W</u>	<u>E-1</u>
	T _____ R _____	_____
	T _____ R _____	_____
	T _____ R _____	_____
2. Property Controlling	S _____ T _____ R _____	_____
in Section	S _____ T _____ R _____	_____
3. Miscellaneous	S _____ T _____ R _____	_____
Property in Sec.	S _____ T _____ R _____	_____
4. Lot No. _____	Recorded Plat _____	
5. Private Claims _____		

LIBER 5 PAGE 228  
STATE OF MICHIGAN  
ST. JOSEPH COUNTY  
FILED

22 DEC 1999 10:59:50 AM

CYNTHIA L. JARRATT  
REGISTER OF DEEDS

Register of Deeds Stamp & Filing Number

I, Donald C. Andrews, in a field survey on November, 1999, do hereby certify that under requirements of P.A. 74, Michigan P.A. of 1970, the corner points mentioned in lines 1 and 2 above were in conformance with regulations and rules therefor as required in the current manual of survey instructions of the United States Department of the Interior, Bureau of Land Management or by a decree of a Court of Law and/or that the corners mentioned in lines 3, 4 and 5 above were in conformance with the rules of the Michigan Board of Land Surveyors or by a Decree of a Court of Law; established, re-established, monument, re-monumented, recovered, found as expressed below:

NOTE: Not more than 2 corners, all in the same town and range, may be Recorded on this certificate.

A. Description of original monument and accessories and/or Subsequent restoration:

LCRC 5, PAGE 9

B. Description of corner evidence found and/or method applied in restoring or reestablishing corner:

Found Remon Capped Iron in Mon Box

The St. Joseph County Land Corners being located were done within specifications for Order "C 2-II". The closest the National Geodetic Reference System monument having a position order of "B" incorporated in the traverse network was the monument having the PID of "AA8117" with Station Name of "IRS-F". The maximum positional error of each Land Corner monument being located would be less than 0.08 feet relative to the connecting HARN control monuments of the National Geodetic Reference System based on a 95% confidence level.

C. Description of monument for corner and accessories to perpetuate locating the position of the corner:

Found Remon Capped Iron in Mon Box


It's coordinates in international feet are: Northing 114836.9690, Easting 12849912.3459

Witness: Cut off UP S70°E 53.50', RR AP S55°W 31.60', UP S65°W 60.99', 14" Oak S75°W 79.47'

RATIFIED BY PEER GROUP  
IN ACCORDANCE WITH P.A. 345  
ON NOV. 14, 1996  
Warr. CO. REPRESENTATIVE  
12/21/99 Warr

Signed by Donald Andrews Date 12-20-99

Surveyors Michigan License No. 33967

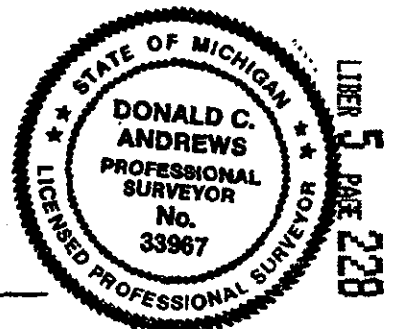

REMONUMENTATION