

SURVEY & REMONUMENTATION

JUL 16 1998

SECTION

LAND CORNER RECORDATION CERTIFICATE
Filing Requirement of Act 74, Mich. P.A. 1970

LIBER 5 PAGE 83

STATE OF MICHIGAN
ST. JOSEPH COUNTY
FILED

26 JUN 1998 4:37:08 PM

CYNTHIA L. JARRATT
REGISTER OF DEEDS

Register of Deeds Stamp & File Number

For corners in
St. Joseph Located In: Corner Code #
(County)

1. Public Land Survey T 8 S R 9W F-3
T ___ R ___
T ___ R ___
T ___ R ___

2. Property Controlling S ___ T ___ R ___
in Section S ___ T ___ R ___

3. Miscellaneous S ___ T ___ R ___
Property in Sec. S ___ T ___ R ___

4. Lot No. _____, Recorded Plat _____

5. Private Claims _____

I, Donald C. Andrews, in a field survey on March, 1998, do hereby certify that under requirements of P.A. of 1970, the corner points mentioned in lines 1 and 2 above were in conformance with regulations and rules therefore as required in the current manual of survey instructions of the United States Department of the Interior, Bureau of Land Management or by a decree of a Court of Law and/or that the corner points mentioned in lines 3, 4 and 5 above were in conformance with the rules of the Michigan Board of Land Surveyors or a Decree of a Court of Law; established, re-established, monumented, re-monumented, recovered, found as expressed below:

NOTE: Not more than 2 corners, all in the same town and range, may be recorded on this certificate.

A. Description of original monument and accessories and/or subsequent restoration:

GLO POST

CO. SURVEYOR'S RECORD BK. A, P. 721, 1896 SAM REED LARGE STONE "X" SET FROM BOTH ORIGINAL BEARINGS NO WITNESSES

CO. SURVEYOR'S RECORD BK B, P.375, 1907 MCCOY FOUND BY FORMER SURVEYOR (NO DESCRIPTION OR WITNESSES)

1937 SURVEY BY NICHOLSON SHOWS STONE FOR S1/4 CORNERS SEC. 4

MOSTROM 1980- FOUND "X" STONE, A.P. WEST 62', 1' N OF E-W FENCE PK NAIL IN 18" HEDGE N75°W 8.85', 6" HEDGE S30°W 5.70', 12" HEDGE S20°E 4.55'

B. DESCRIPTION OF CORNER EVIDENCE FOUND AND/OR METHOD APPLIED IN RESTORING OR REESTABLISHING CORNER:


FOUND "X"-POINTED STONE (1.8'Hx1.2'x1.8') 1' N. OF E-W FENCE 62' E OF A.P. 16" HEDGE S20°E 4.7', 8" HEDGE S30°W 5.8', 18" HEDGE N75°W 9.4'

C. DESCRIPTION OF MONUMENT FOR CORNER AND ACCESSORIES ESTABLISHED TO PERPETUATE LOCATING THE POSITION OF THE CORNER:

MOVED STONE ON SIDE AND SET ALUMINUM CAPPED 5/8x24" IRON IN SAME PLACE WITH STONE CARIN AROUND SET IRON. WITNESS: 14" OAK S5°E 28.34', 24" OAK WEST 19.44', 8" MAPLE N25°E 14.94', 20" MAPLE EAST 32.52'

	A	B	C	D	E	F	G	H	I	J	K	L	M
2	6		5		4		3		2		1		
3						●							
4	7		8		9		10		11		12		
5													
6	18		17		16		15		14		13		
7													
8	19		20		21		22		23		24		
9													
10	30		29		28		27		26		25		
11													
12	31		32		33		34		35		36		
13													

Signed by Donald C. Andrews
Donald C. Andrews, P.S.
Surveyor's Michigan License No. 33967

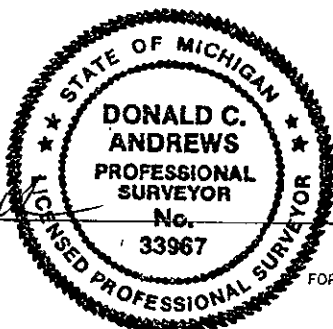

RATIFIED BY PEER GROUP
IN ACCORDANCE WITH P.A. 345
ON 4/13/98, 19
Alva CO. REPRESENTATIVE

Date Mar. 20, 1998

LIBER 5 PAGE 83

FORM APPROVED BY MICHIGAN STATE BOARD OF LAND SURVEYORS., JAN. 28, 1971

REVISED MAY 14, 1975

REVISED JAN., 1983

REVISED JAN., 1995

ADAPTED FOR WORD-PROCESSING

REMONUMENTATION