

SURVEY & REMONUMENTATION

APR 07 1998

LAND CORNER RECORDATION CERTIFICATE Filing Requirement of Act 74, Mich. P.A. 1970

LIBER 5 PAGE 39

SECTION For corners in

ST. JOSEPH
(County)
FAWN RIVER TWP.
1. Public Land Survey

Located In:	Corner Code #
T 8S R 9W	G-2
T R	
T R	
T R	
S T R	
S T R	
S T R	
S T R	

STATE OF MICHIGAN
ST. JOSEPH COUNTY
FILED

14 NOV 97 8:18 A.M.


CYNTHIA JARRATT
REGISTER OF DEEDS

Register of Deeds Stamp & File Number

4. Lot No. _____ Recorded Plat _____
5. Private Claims _____

I, DAVID W. MOSTROM, in a field survey on NOV. 5, 1997, do hereby state that under requirements of P.A. 74, Michigan P.A. of 1970, the corner points mentioned in lines 1 and 2 above were in conformance with regulations and rules therefore as required in the current manual of survey instructions of the United States Department of the Interior, Bureau of Land Management or by a decree of a Court of Law and for that the corner points mentioned in lines 3, 4 and 5 above were in conformance with the rules of the Michigan Board of Land Surveyors or by a Decree of a Court of Law; established, re-established, monumented, recovered, found as expressed below:

NOTE: Not more than 2 corners, all in the same town and range, may be recorded on this certificate.

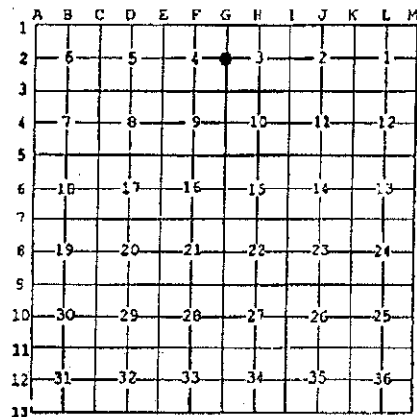

A. Description of original monument and accessories and/or subsequent restoration:

(G-2) 1/4 CORNER COMMON TO SECTIONS 3 & 4 T8S, R9W

*1949 M.D.O.T.

STONE 1' FROM FENCE

15" OAK = N11°E 64.52'

FENCE POST = N63°W 5.73'

CL HWY. U.S. 12=SOUTH 891.16'

*1959, 1961 AND 1968 SAYERS

SURVEY FOR SWEET LAKE MOBILE HOME PARK

CORNER IS NOT LABELED

IRON = WEST 16.50'

IRON = EAST 16.50'

CL HWY U.S. 12=SOUTH 890.09'

*1974 LCRC IN BOOK 1, PG. 31

FOUND 1 1/2" PIPE BY SAYERS

24" OAK = NORTH 62.61'

FENCE POST = N89°W 15.21'

TELE. POLE = S89°E 23.22'

*1975 LCRC IN BOOK 3, PG. 141

FOUND 3/4" PIPE

P. POLE = EAST 22.67'

30" W. OAK = NE 62.94'

CONC. FOUNDATION = NW 62.94'

B. Description of corner evidence found and/or method applied in restoring or reestablishing corner:

(G-2)

FOUND CAPPED IRON OVER BENT 3/4" (ID) X 12" PIPE IN ASPHALT ROADWAY

DUG 1' X 1' X 3.5' DEEP HOLE UNDER IRON BUT FOUND NO STONE

32" W. OAK = N11°E 64.50'

TELE. POLE = EAST 22.67' TO FACE

S89°E 23.22' TO NAIL 5' HIGH ON NORTH SIDE

SE HOUSE CORNER = NW 62.94'

IRON FALLS IN PROJ. OF TREELINES TO EAST & WEST

RATIFIED BY PEER GROUP
IN ACCORDANCE WITH P.A. 345
ON Nov. 10, 1997, 19
State CO. REPRESENTATIVE

C. Description of monument for corner and accessories established to perpetuate locating the position of the corner:

(G-2)

SET 5/8" X 24" IRON BAR W/STD. CAP IN MON. BOX IN PLACE OF IRON FOUND

NW COR. GARAGE = N63°E 62.85'

SE COR. HOUSE = N32°W 62.94'


N & W 0.5' HIGH IN S. SIDE OF P. POLE = EAST 22.92'

N & W 1.0' HIGH IN SW SIDE OF P. POLE = N32°W 38.50'

N & W 2.0' HIGH IN E. SIDE OF 32" OAK = N11°E 64.50'

Signed by J. Mostrom DAVID W. MOSTROM
Surveyor's Michigan License No. 32339

Date NOVEMBER 12, 1997

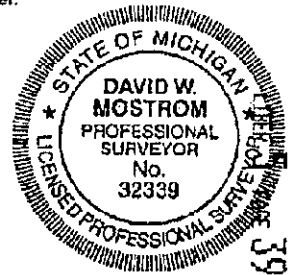

REMONUMENTATION

27