

SURVEY & REMONUMENTATION

MAR - 8 2001

SECTION

LAND CORNER RECORDATION CERTIFICATE
Filing Requirement of Act 74, Mich. P.A. 1970

LIBER 5 PAGE 193

STATE OF MICHIGAN
ST. JOSEPH COUNTY
FILED

21 SEP 1999 1:09:17 PM

CYNTHIA L. JARRATT
REGISTER OF DEEDS

Register of Deeds Stamp & File Number

For corners in

ST. JOSEPH
(County)

Located In:

Corner Code #

1. Public Land Survey	T8S R 9W	K-5
	T R	
	T R	
	T R	
2. Property Controlling in Section	S T R	
	S T R	
3. Miscellaneous Property in Sec.	S T R	
	S T R	

4. Lot No. _____, Recorded Plat _____
5. Private Claims _____

I, WAYNE A. MOSTROM, in a field survey on AUG. 12, 1999 do hereby state that under requirements of P.A. 74, Michigan P.A. of 1970, the corner points mentioned in lines 1 and 2 above were in conformance with regulations and rules therefore as required in the current manual of survey instructions of the United States Department of the Interior, Bureau of Land Management or by a decree of a Court of Law and for that the corner points mentioned in lines 3, 4 and 5 above were in conformance with the rules of the Michigan Board of Land Surveyors or by a Decree of a Court of Law; established, re-established, monumented, recovered, found as expressed below:

NOTE: Not more than 2 corners, all in the same town and range, may be recorded on this certificate.

1	A	B	C	D	E	F	G	H	I	J	K	L	M
2		6		5		4		3		2		1	
3													
4		7		8		9		10		11		12	
5													
6		18		17		16		15		14		13	
7													
8		19		20		21		22		23		24	
9													
10		30		29		28		27		26		25	
11													
12		31		32		33		34		35		36	
13													

A. Description of original monument and accessories and/or subsequent restoration:

GLO
 13" Y.O. = N11°E 38½ LKS (25.41')
 11" Y.O. - S74°W 27 LKS (17.82')

1872 SURVEY IN A/194
 "SET BY ORIGINAL BRG'S"

1974 SURVEY & LCRC
 IN 3/150
 IRON BAR SET
 POST = NE 22.38'
 10" LOCUST STUMP =
 SW 62.35'
 P.P. = NW 35.51'


B. Description of corner evidence found and/or method applied in restoring or reestablishing corner:

FOUND ½" X 18" CAPPED IRON IN MON. BOX
 P.O. = NW 35.51'
 POST = NE 22.38'

RATIFIED BY PEER GROUP
 IN ACCORDANCE WITH P.A. 345
 ON Sept. 13, 1999
Wayne CO. REPRESENTATIVE

C. Description of monument for corner and accessories established to perpetuate locating the position of the corner:

SET 5/8" X 24" BAR W/STD. CAP IN MON. BOX
 N & W IN NW SIDE 24" TR1-OAK = N70°E 27.25'
 N & W IN S SIDE A.P. = N86°E 22.74'
 N & W IN S SIDE 18" CHERRY = S83°E 34.81'
 N & W IN S SIDE P.P. = N77°W 35.51'

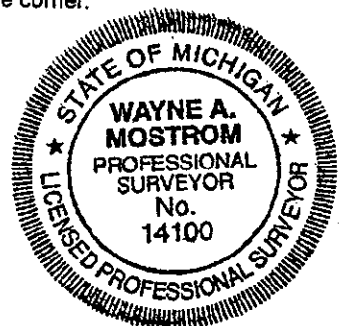

LIBER 5 PAGE 193

Signed by Wayne A. Mostrom WAYNE A. MOSTROM
 Surveyor's Michigan License No. 14100

Date SEPTEMBER 14, 1999