

**SURVEY &
REMONUMENTATION**

JUL 16 1998

**LAND CORNER RECORDATION CERTIFICATE
Filing Requirement of Act 74, Mich. P.A. 1971**

SECTION

LIBER 5 PAGE 55

For Corners in

<u>St. Joseph</u> (County)	Located In:	Corner Code #
1. Public Land Survey	T <u>8S</u> R <u>11W</u>	<u>A-3</u>
	T _____ R _____	_____
	T _____ R _____	_____
	T _____ R _____	_____
2. Property Controlling in Section	S _____ T _____ R _____	_____
	S _____ T _____ R _____	_____
3. Miscellaneous Property in Sec.	S _____ T _____ R _____	_____
	S _____ T _____ R _____	_____
4. Lot No. _____, Recorded Plat _____		
5. Private Claims _____		

STATE OF MICHIGAN
ST. JOSEPH COUNTY
FILED

15 APR 1998 3:30:14 PM

CYNTHIA L. JARRATT
REGISTER OF DEEDS

Register of Deeds Stamp & Filing Number

	A	B	C	D	E	F	G	H	I	J	K	L	M
2	6		5		4		3		2		1		
3													
4	7		8		9		10		11		12		
5													
6	18		17		16		15		14		13		
7													
8	19		20		21		22		23		24		
9													
10	30		29		28		27		26		25		
11													
12	31		32		33		34		35		36		
13													

I, Donald C. Andrews, in a field survey on 25 November, 1997, do hereby certify that under requirements of P.A. 74, Michigan P.A. of 1970, the corner points mentioned in lines 1 and 2 above were in conformance with regulations and rules therefor as required in the current manual of survey instructions of the United States Department of the Interior, Bureau of Land Management or by a decree of a Court of Law and/or that the corners mentioned in lines 3, 4 and 5 above were in conformance with the rules of the Michigan Board of Land Surveyors or by a Decree of a Court of Law; established, re-established, monument, re-monumented, recovered, found as expressed below:

NOTE: Not more than 2 corners, all in the same town and range, may be Recorded on this certificate.

A. Description of original monument and accessories and/or Subsequent restoration:

GLO Post Set post 25 links north of SE Corner of Sec. 1, T8S, R12W
H. Fisk (not licensed) shows corner 16.5 feet north of SE Corner Sec. 1
Sayers records shows a 1" iron shaft


B. Description of corner evidence found and/or method applied in restoring or reestablishing corner:

No iron detected. Set temporary point 16.5 feet north of SE Corner Sec. 1 on line of E1/4 Corner of Sec. 1. Dug 14" diameter hole 30" deep. Found nothing. Set corner at the record GLO distance for location of SW Corner of Section 6, T8S, R11W. as best evidence of location of corner.

**RATIFIED BY PEER GROUP
IN ACCORDANCE WITH P.A. 345
ON Nov. 10, 19 97
Andrews CO. REPRESENTATIVE**

C: Description of monument for corner and accessories to perpetuate locating the position of the corner:

Set 5/8" x 24" iron with standard Aluminum cap in monument box: PP S25°W 66.55', PP N25°W 58.87', 10" Maple N45°E 60.55', SE corner of house is West 58.14', SE Corner Sec. 1 is South 16.50'

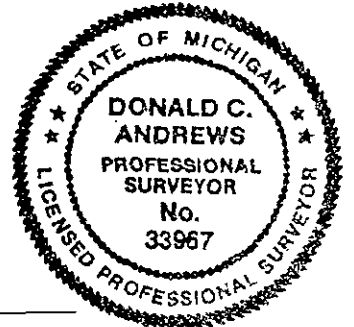

Signed by Donald C. Andrews Date 11/25/97

Surveyors Michigan License No. 33967

FORM APPROVED BY MICHIGAN STATE BOARD OF LAND SURVORS, JAN. 28, 1971
REVISED MAY 14, 1975
REVISED JAN., 1983
REVISED OCT., 1996
ADAPTED FOR WORD PROCESSING

REMONUMENTATION

LIBER 5 PAGE 55