

NOV 04 1997

COMMISSION

LAND CORNER RECORDATION CERTIFICATE
Filing Requirement of Act 74, Mich. P.A. 1970 LIBER 5 PAGE 12

For corners in
St. Joseph Located In: Corner Code #
(County)

1. Public Land Survey T 8S R 11W C-2
T R
T R
T R

2. Property Controlling in Section S T R
S T R

3. Miscellaneous Property in Sec. S T R
S T R

4. Lot No. Recorded Plat

5. Private Claims

STATE OF MICHIGAN
ST. JOSEPH COUNTY
FILED
7 AUG 97 3:51 P.M.
CYNTHIA JARRATT
REGISTER OF DEEDS
Register of Deeds Stamp & File Number

I, Donald C. Andrews, in a field survey on May 13, 1997, do hereby certify that under requirements of P.A. of 1970, the corner points mentioned in lines 1 and 2 above were in conformance with regulations and rules therefore as required in the current manual of survey instructions of the United States Department of the Interior, Bureau of Land Management or by a decree of a Court of Law and/or that the corner points mentioned in lines 3, 4 and 5 above were in conformance with the rules of the Michigan Board of Land Surveyors or a Decree of a Court of Law; established, re-established, monumented, re-monumented, recovered, found as expressed below:

NOTE: Not more than 4 corners, all in the same town and range, may be recorded on this certificate.

A. Description of original monument and accessories and/or subsequent restoration:

GLO Post

Sam Reed 1904 Bk 1, P. 80 Information on page appears that he did not find the corner. He has the distance from the NW of 5 to the SW of 5 with distance to point "E" from both. No distance to the W1/4 Sec. 5 given.

LCRC 2, P235 fd 1" pipe in mon box per plat of "Morris's Sub. No. 2" centerline of Lutz Rd. wit: P. Pole S77°W 29.46', 8" MAPLE N81°30'W 71.5', 12" MAPLE S62°W 48.8', in existing centerline of road

Sayers survey 1978 #10679 - no description
Plat of Morris Subd. shows existing corner on plat dated 1967

Mostrom survey they did in June of 91 they found a 1" pipe with wit same as LCRC 2, P 99

B. Description of corner evidence found and/or method applied in restoring or reestablishing corner:

found 1 1/4" pipe x 1.2 long in mon box. ref and removed box. dug 18" dia. hole 4.3 ft. deep (4 ft to subgrade) nothing found.


distance to P. Pole and to 8" Maple checked with LCRC 2, P235. corner found was located in centerline of N-S road

RATIFIED BY PEER GROUP
IN ACCORDANCE WITH P.A. 345
ON MAY 12, 1997
CO. REPRESENTATIVE

C. Description of monument for corner and accessories established to perpetuate locating the position of the corner:

reset corner with 5/8" x 24" alum. capped iron in mon box: 1) PP S80°W 29.42', 2) SCI (set capped iron) N15°W 50.54', SCI N45°E 25.10', SCI S35°E 42.52'

Signed by Donald C. Andrews
Donald C. Andrews, P.S.
Surveyor's Michigan License No. 33967

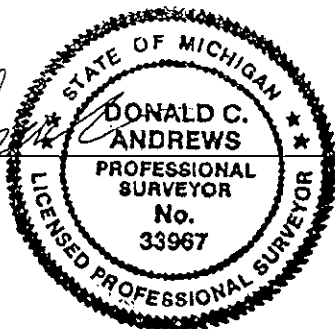

Date 5/30/97