

REMONUMENTATION SURVEY & RECORDATION

LAND CORNER RECORDATION CERTIFICATE
Filing Requirement of Act 74, Mich. P.A. 1970

004 PG 027

For corners in

ST. JOSEPH
(County)

Located In:

Corner Code //

FILED

APR 28 1 09 PM '94

Cynthia R. Janotti

REGISTER OF DEEDS
ST. JOSEPH COUNTY

Register of Deeds Stamp & File Number

- 1. Public Land Survey T 8S R 11W D-5
T R
T R
T R
- 2. Property Controlling S T R
in Section S T R
- 3. Miscellaneous S T R
Property in Sec. S T R
- 4. Lot No. , Recorded Plat
- 5. Private Claims

	A	B	C	D	E	F	G	H	I	J	K	L	M
2	6		5		4		3		2		1		
3													
4	7		8		9		10		11		12		
5													
6	18		17		16		15		14		13		
7													
8	19		20		21		22		23		24		
9													
10	30		29		28		27		26		25		
11													
12	31		32		33		34		35		36		
13													

I, WAYNE A. MOSTROM, in a field survey on _____ 19____
do hereby certify that under requirements of P.A. 74, Michigan P.A. of 1970, the corner points mentioned in lines 1 and 2 above were in conformance with regulations and rules therefore as required in the current manual of survey instructions of the United States Department of the Interior, Bureau of Land Management or by a decree of a Court of Law and/or that the corner points mentioned in lines 3, 4 and 5 above were in conformance with the rules of the Michigan Board of Land Surveyors or by a Decree of a Court of Law; established, re-established, monumented, re-monumented, recovered, found as expressed below:

NOTE: Not more than 4 corners, all in the same town and range, may be recorded on this certificate.

A. Description of original monument and accessories and/or subsequent restoration:


GLO 1970 SURVEYS BY PIERCE
12" SYCAMORE = N15°E .6 LKS NOTES SHOW REMAINS OF ANCHOR POST WAS USED.
9" B. ASH = S35°W .15 LKS
1898 SURVEY
NO CORNER FOUND

1992 SURVEY BY STRATER
CORNER WAS SET (1/2" BAR MIDWAY BET. SEC. COR & 1/4 COR.
8" OAK = N25°W 7.41'
14" MAP = N86°E 11.5'
16" MAP = S50°W 44.7'
12" ASH = S14°W 58.1'

B. Description of corner evidence found and/or method applied in restoring or reestablishing corner:

FD. 1/2" BAR CAPPED #28424 REMAINS OF VERY LARGE SYCAMORE = N15°E 6 LKS
8" OAK = N25°W 7.4'
14" MAP = N86°E 11.5'
16" MAP = S50°W 44.7'
12" ASH = S14°W

NOTE: CORNER DISAGREES WITH 1/4 LINE PER SAYERS SURVEY RECORDED IN E 69, PAGE 25. A.P. USED BY PIERCE IS ABOUT 6.7' W.

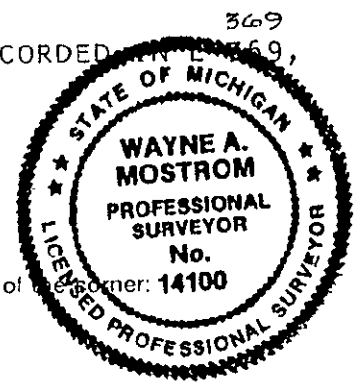

C. Description of monument for corner and accessories established to perpetuate localing the position of the corner:

1/4 CORNER COMMON TO SECTIONS 8 & 17
SET 5/8"X24" BAR WITH STANDARD CAP
N & W IN 8" OAK = S25°W 7.40'
N & W IN 14" MAPLE = N86°E 11.50'
N & W IN 16" MAPLE = S50°W 44.60'
N & W IN 12" ASH = S14°W 58.07'
CORNER IS 1' N. OF E.-W. FENCE REMAINS
EDGE RIVER = WEST 67'±

APPROVED BY PEER GROUP AS PERPETUATION OF ORIGINAL CORNER 3/14/94

Signed by *Wayne A. Mostrom*
Surveyor's Michigan License No. 14100

Date 4/13/94 NISC. 7.00 4-28-94

REMONUMENTATION