

SURVEY & REMONUMENTATION

MAR 24 2000

SECTION

LAND CORNER RECORDATION CERTIFICATE
Filing Requirement of Act 74, Mich. P.A. 1970

For corners in

LIBER 4 PAGE 275

ST. JOSEPH Located In: Corner Code #
(County)
WHITE PIGEON TWP.
1. Public Land Survey T 8S R 11W H-3
T R
T R
T R
2. Property Controlling S T R
in Section S T R
3. Miscellaneous S T R
Property in Sec. S T R

STATE OF MICHIGAN
ST. JOSEPH COUNTY
FILED

5 DEC 96 12:36 P.M.


CYNTHIA JARRATT
REGISTER OF DEEDS

Register of Deeds Stamp & File Number

4. Lot No. _____, Recorded Plat _____
5. Private Claims _____

I, WAYNE A. MOSTROM, in a field survey on NOV. 15, 1996 do hereby state that under requirements of P.A. 74, Michigan P.A. of 1970, the corner points mentioned in lines 1 and 2 above were in conformance with regulations and rules therefore as required in the current manual of survey instructions of the United States Department of the Interior, Bureau of Land Management or by a decree of a Court of Law and for that the corner points mentioned in lines 3, 4 and 5 above were in conformance with the rules of the Michigan Board of Land Surveyors or by a Decree of a Court of Law; established, re-established, monumented, recovered, found as expressed below:

NOTE: Not more than 2 corners, all in the same town and range, may be recorded on this certificate.

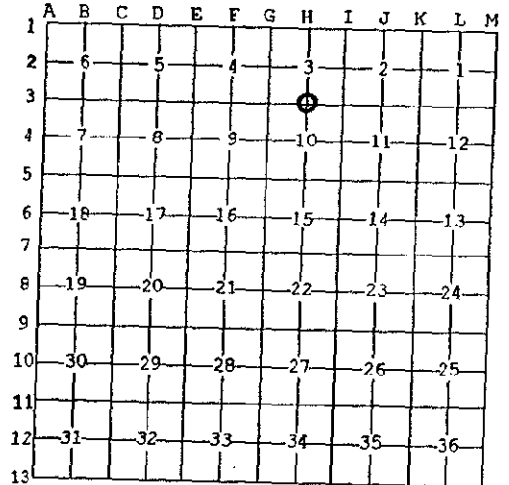

A. Description of original monument and accessories and/or subsequent restoration:

GLO - POST 1969 BY E.J. MCCOMBS
 18" W.O.=N18°E 27 LKS USED MIDWAY BETWEEN
 13" R.O.=S25°W 39 LKS SEC. CORNERS-NO CORNER SET

1867 SURVEY IN BOOK A, PAGE 150
STAKE EQUIDISTANT BET. CORNERS
5" BLK. WAL. = EAST 2 1/2 LKS
7" APPLE = S18 1/4°E 49 LKS


B. Description of corner evidence found and/or method applied in restoring or reestablishing corner:

FOUND OLD ROTTED/HOLLOW REMAINS OF BLACK WALNUT STUMP @ 2 1/2 LKS EAST

RATIFIED BY PEER GROUP
IN ACCORDANCE WITH P.A. 345
ON Nov. 14, 1996
Wayne CO. REPRESENTATIVE

C. Description of monument for corner and accessories established to perpetuate locating the position of the corner:

SET 5/8"X48" IRON BAR W/STD. REMON. CAP ON LINE BETWEEN SW & SE CORNERS AT GLO DISTANCE FROM OLD WITNESS TREE
 SW COR. BARN = N10°E 111.35'
 SE COR. BARN = N40°E 138.50'
 P. POLE = S53°E 9.69'
 HWY. R/W CONC. MON. = S30°W 103.12'
 NW COR. BARN = S18°E 64.41'

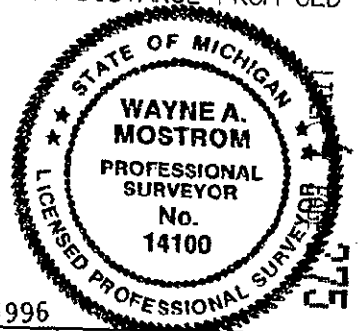

Signed by Wayne A. Mostrom
Surveyor's Michigan License No. 14100

Date NOVEMBER 29, 1996

REMONUMENTATION