

RE

SECTION

LAND CORNER RECORDATION CERTIFICATE
Filing Requirement of Act 74, Mich. P.A. 1971

For Corners in

St. Joseph Located In: Corner Code #
(County)

1. Public Land Survey T 8S R 12W C-4
T _____ R _____
T _____ R _____
T _____ R _____

2. Property Controlling S _____ T _____ R _____
in Section S _____ T _____ R _____

3. Miscellaneous S _____ T _____ R _____
Property in Sec. S _____ T _____ R _____

4. Lot No. _____, Recorded Plat _____

5. Private Claims _____

LIDER 5 PAGE 239
STATE OF MICHIGAN
ST. JOSEPH COUNTY
FILED

22 DEC 1999 11:03:13 AM

CYNTHIA L. JARRATT
REGISTER OF DEEDS

Register of Deeds Stamp & Filing Number

I, Donald C. Andrews, in a field survey on November, 1999, do hereby certify that under requirements of P.A. 74, Michigan P.A. of 1970, the corner points mentioned in lines 1 and 2 above were in conformance with regulations and rules therefor as required in the current manual of survey instructions of the United States Department of the Interior, Bureau of Land Management or by a decree of a Court of Law and/or that the corners mentioned in lines 3, 4 and 5 above were in conformance with the rules of the Michigan Board of Land Surveyors or by a Decree of a Court of Law; established, re-established, monument, re-monumented, recovered, found as expressed below:

NOTE: Not more than 2 corners, all in the same town and range, may be Recorded on this certificate.

A. Description of original monument and accessories and/or Subsequent restoration:

LCRC 4, PAGE 252

B. Description of corner evidence found and/or method applied in restoring or reestablishing corner:

Found Remon Capped Iron in Mon Box

The St. Joseph County Land Corners being located were done within specifications for Order "C 2-II". The closest the National Geodetic Reference System monument having a position order of "B" incorporated in the traverse network was the monument having the PID of "MD1335" with Station Name of "Q 122". The maximum positional error of each Land Corner monument being located would be less than 0.08 feet relative to the connecting HARN control monuments of the National Geodetic Reference System based on a 95% confidence level.

C. Description of monument for corner and accessories to perpetuate locating the position of the corner:

Found Remon Capped Iron in Mon Box

It's coordinates in international feet are: Northing 107721.1997, Easting 12748679.7500.

Witness: 22" Sassafras S59°E 25.50', 24" Oak East 24.80', 10" Oak S20°E 59.55', 18" Oak N78°E 28.35'

RATIFIED BY PEER GROUP
IN ACCORDANCE WITH P.A. 345
ON SEPT. 9, 1996
_____ CO. REPRESENTATIVE

12/21/99 Klein

Signed by


Donald C. Andrews

Date

12-20-99

Surveyors Michigan License No. 33967

	A	B	C	D	E	F	G	H	I	J	K	L	M
2	6		5		4		3		2		1		
3													
4	7		8		9		10		11		12		
5													
6	18		17		16		15		14		13		
7													
8	19		20		21		22		23		24		
9													
10	30		29		28		27		26		25		
11													
12	31		32		33		34		35		36		
13													

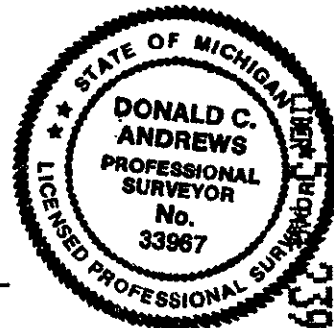

FORM APPROVED BY MICHIGAN STATE BOARD OF LAND SURVORS, JAN. 28, 1971
REVISED MAY 14, 1975
REVISED JAN., 1983
REVISED OCT., 1995
ADAPTED FOR WORD PROCESSING

REMONUMENTATION