

**SURVEY & REMONUMENTATION**

JUL 16 1998

**SECTION**

**LAND CORNER RECORDATION CERTIFICATE**  
Filing Requirement of Act 74, Mich. P.A. 1970

LIBER 5 PAGE 57

For corners in

ST. JOSEPH

(County)

Located In:

Corner Code #

MOTTVILLE TWP  
1. Public Land Survey

T 8S	R 12W	F-5
T	R	
T	R	
T	R	
T	R	
S	T	R
S	T	R
S	T	R
S	T	R

- 2. Property Controlling in Section
- 3. Miscellaneous Property in Sec.

STATE OF MICHIGAN  
ST. JOSEPH COUNTY  
FILED

15 Apr 1998 3:31:06 PM

CYNTHIA L. JARRATT  
REGISTER OF DEEDS

Register of Deeds Stamp & File Number

- 4. Lot No. \_\_\_\_\_, Recorded Plat \_\_\_\_\_
- 5. Private Claims \_\_\_\_\_

I, WAYNE A. MOSTROM, in a field survey on MARCH 31, 1998 do hereby state that under requirements of P.A. 74, Michigan P.A. of 1970, the corner points mentioned in lines 1 and 2 above were in conformance with regulations and rules therefore as required in the current manual of survey instructions of the United States Department of the Interior, Bureau of Land Management or by a decree of a Court of Law and /or that the corner points mentioned in lines 3, 4 and 5 above were in conformance with the rules of the Michigan Board of Land Surveyors or by a Decree of a Court of Law; established, re-established, monumented, recovered, found as expressed below:

	A	B	C	D	E	F	G	H	I	J	K	L	M
2		6		5		4		3		2		1	
3													
4		7		8		9		10		11		12	
5						16		15		14		13	
6		18		17		16		15		14		13	
7													
8		19		20		21		22		23		24	
9													
10		30		29		28		27		26		25	
11													
12		31		32		33		34		35		36	
13													

NOTE: Not more than 2 corners, all in the same town and range, may be recorded on this certificate.

A. Description of original monument and accessories and/or subsequent restoration:

<u>GLO</u>	<u>1983 LCRC IN 2/164</u>
16" W.O. = S8°W 29½ LKS	STO. IN MON. BOX
8" W.O. = N27°E 9 LKS	24" MAPLE = N62°E 44.3'
	13" WAL. = S31°E 19.95'
<u>ROAD COMMISSION - 1965</u>	COR. IS 4' SOUTH OF CENTERLINE
<u>FOUND SMALL POINTED STONE IN BOX</u>	GRAVEL ROADWAY
A.P. = NORTH 21.49'	STONE IS 10" DEEP
19" MAPLE = N62°E 44.3'	
11" WAL. = S31°E 19.95'	


B. Description of corner evidence found and/or method applied in restoring or reestablishing corner:

FOUND 3/4" X 15" PIPE OVER SMALL POINTED STONE WITH TRACE OF NOTCH 22" BELOW SURFACE. (ROAD WAS REWORKED IN RECENT YEARS AND A FILL PLACED IN THIS AREA)  
CORNER FOUND IS IN FENCELINE TO NORTH AND 1' SOUTH OF CENTERLINE ROADWAY. (PAVED)  
ALL OF THE ABOVE WITNESSES WERE OUT.

RATIFIED BY PEER GROUP  
IN ACCORDANCE WITH P.A. 345  
ON April 13; 1998  

C. Description of monument for corner and accessories established to perpetuate locating the position of the corner:

SET 5/8" X 24" BAR W/STD CAP OVER STO. IN MON. BOX  
N & W IN E. SIDE A.P. = NORTH 32.84'  
N & W IN W. SIDE 8" WAL. = N25°W 69.8'  
N & W IN W. SIDE 13" WAL. = N49°W 56.82'  
M & W IN SE SIDE P. POLE = S63°W 130.69'

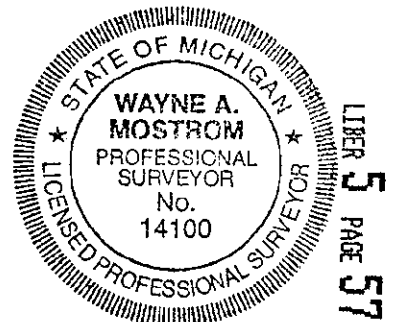

Signed by Wayne A. Mostrom WAYNE A. MOSTROM  
Surveyor's Michigan License No. #14100

Date APRIL 14, 1998