

SURVEY & REMONUMENTATION

FEB 08 2000

SECTION

LAND CORNER RECORDATION CERTIFICATE
Filing Requirement of Act 74, Mich. P.A. 1970

For corners in Mottville Twp.

<u>St. Joseph</u> (County)	Located In:	Corner Code #
1. Public Land Survey	T <u>8S</u> R <u>12W</u>	<u>G-3</u>
	T <u> </u> R <u> </u>	<u> </u>
	T <u> </u> R <u> </u>	<u> </u>
	T <u> </u> R <u> </u>	<u> </u>
2. Property Controlling in Section	S <u> </u> T <u> </u> R <u> </u>	<u> </u>
	S <u> </u> T <u> </u> R <u> </u>	<u> </u>
3. Miscellaneous Property in Sec.	S <u> </u> T <u> </u> R <u> </u>	<u> </u>
	S <u> </u> T <u> </u> R <u> </u>	<u> </u>

LIBER 6 PAGE 12

STATE OF MICHIGAN
ST. JOSEPH COUNTY
FILED

7 JAN 2000 9:49:12 AM

CYNTHIA L. JARRATT
REGISTER OF DEEDS

Register of Deeds Stamp & File Number

4. Lot No. , Recorded Plat
5. Private Claims

I, Wayne A. Mostrom, in a field survey on 7/15, 1999 do hereby state that under requirements of P.A. 74, Michigan P.A. of 1970, the corner points mentioned in lines 1 and 2 above were in conformance with regulations and rules therefore as required in the current manual of survey instructions of the United States Department of the Interior, Bureau of Land Management or by a decree of a Court of Law and /or that the corner points mentioned in lines 3, 4 and 5 above were in conformance with the rules of the Michigan Board of Land Surveyors or by a Decree of a Court of Law; established, re-established, monumented, recovered, found as expressed below:

NOTE: Not more than 2 corners, all in the same town and range, may be recorded on this certificate.

1	A	B	C	D	E	F	G	H	I	J	K	L	M
2		6		5		4		3		2		1	
3							9						
4		7		8		9		10		11		12	
5													
6		18		17		16		15		14		13	
7													
8		19		20		21		22		23		24	
9													
10		30		29		28		27		26		25	
11													
12		31		32		33		34		35		36	
13													

A. Description of original monument and accessories and/or subsequent restoration:

<u>1916 Survey in B/496</u> Stone	<u>Road Comm. 1966</u> 7" Elm=N34°W 73.87' NE barn cor.=N53°W 31.19' SE barn cor.=W. 25.26' Nail in C hwy.=N. 182.3'	<u>1983 LCRC in 2/164</u> 3/4" pipe in Mon. box NE cor. barn = N53°W 31.19' SE cor. barn = W. 25.26' PK nail = N. 163.65'	<u>Sayers 1974 Survey</u> Stone in box w/brick <u>Stephenson 1997 Survey</u> Rebar in box
--------------------------------------	--	---	--


B. Description of corner evidence found and/or method applied in restoring or reestablishing corner:

Fd. 1/2" x 18" Iron capped #33967 over sto. In Mon. box
C old seam in hwy = N. 182.3'
Depression from old tree @ N34°W 73.87'
Barn cor's check per above witnesses
Good "Bite" w/wand at 163.65' North
Cor. is in C N-S rdwy.

**RATIFIED BY PEER GROUP
IN ACCORDANCE WITH P.A. 345
ON Aug. 9, 1999
Wayne CO. REPRESENTATIVE**

C. Description of monument for corner and accessories established to perpetuate locating the position of the corner:

Set 5/8" x 18" bar w/std. cap in conc. in Mon. box over stone
NE cor. barn = N53°W 31.19'
SE cor. barn = West 25.26'
N & W in SE side 3" fen. post = N42°E 43.13'
N & W in W. side 8" tree = S15°E 108.36'

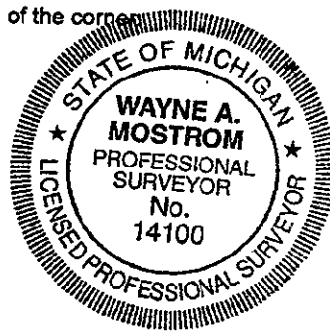

LIBER 6 PAGE 12

Signed by Wayne A. Mostrom
Surveyor's Michigan License No. 14100

Date Dec. 30, 1999