

**SURVEY & REMONUMENTATION**

JUL 16 1998

**SECTION**

**LAND CORNER RECORDATION CERTIFICATE**  
Filing Requirement of Act 74, Mich. P.A. 1970

For corners in

ST. JOSEPH  
(County)  
MOTTVILLE TWP.  
1. Public Land Survey

Located In:	Corner Code #
T 8S R 12W	G-5
T R	
T R	
T R	
S T R	
S T R	
S T R	
S T R	

2. Property Controlling in Section  
3. Miscellaneous Property in Sec.

4. Lot No. \_\_\_\_\_, Recorded Plat \_\_\_\_\_  
5. Private Claims \_\_\_\_\_

LIBER 5 PAGE 59

STATE OF MICHIGAN  
ST. JOSEPH COUNTY  
FILED


15 Apr 1998 3:31:50 PM

CYNTHIA L. JARRATT  
REGISTER OF DEEDS

Register of Deeds Stamp & File Number

I, WAYNE A. MOSTROM, in a field survey on April 2, 1998 do hereby state that under requirements of P.A. 74, Michigan P.A. of 1970, the corner points mentioned in lines 1 and 2 above were in conformance with regulations and rules therefore as required in the current manual of survey instructions of the United States Department of the Interior, Bureau of Land Management or by a decree of a Court of Law and/or that the corner points mentioned in lines 3, 4 and 5 above were in conformance with the rules of the Michigan Board of Land Surveyors or by a Decree of a Court of Law; established, re-established, monumented, recovered, found as expressed below:

NOTE: Not more than 2 corners, all in the same town and range, may be recorded on this certificate.

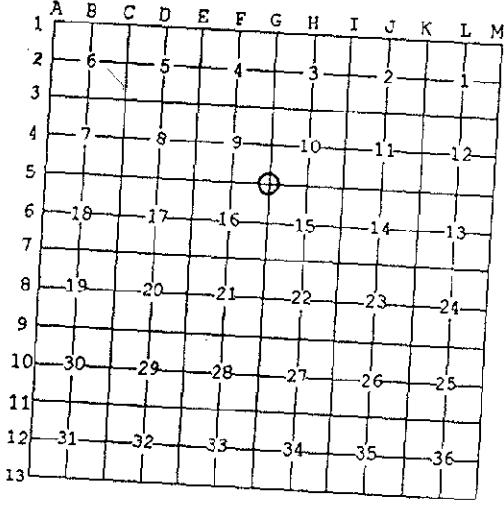

**A. Description of original monument and accessories and/or subsequent restoration:**

1880 SURVEY IN A/417  
W.O. STK IN REMAINS OF ORIGINAL  
10" SASS. = N42½°W 62 LKS  
10" HICK. = S34°W 56 LKS

ROAD COMM. 1963  
STONE IN MON. BOX  
24" HICK. = S36°W 36.35'  
MIDDLE A.P. = N35°W 38.35'  
36" OAK = N32°E 46.9'

1983 LCRC IN L-2, P-164  
FD. STONE IN MON. BOX  
HICK. STUMP = S36°W 36.35'  
14" OAK = N55°W 54.12'  
P. POLE = S54°E 70.33'

1899 SURVEY IN B/31 & 1/5  
+ 'D STONE  
19" HICK. = S35°W 53 LKS  
30" Y.O. = N63½°W 81 LKS


**B. Description of corner evidence found and/or method applied in restoring or reestablishing corner:**

FD. NOTCHED STONE (28" DEEP) IN MON. BOX (20" DEEP)  
RDWY TO N. = EAST 1'  
COR. FALLS IN E-W PROJ. & IN RDWY TO S.  
14" OAK = N55°W 54.12'  
P. POLE = S54°E 70.33'

RATIFIED BY PEER GROUP  
IN ACCORDANCE WITH P.A. 345  
ON April 13, 1998  
Wayne CO. REPRESENTATIVE

**C. Description of monument for corner and accessories established to perpetuate locating the position of the corner:**

SET 5/8" X 19" BAR OVER STONE IN MON. BOX  
N & W IN SW SIDE OF 20" OAK=N50°W 54.25'  
N & W IN NE SIDE P. POLE PEDESTAL=N47°W 45.76'  
N & W IN SW SIDE P.POLE=S54°E 70.78'  
N & W IN W SIDE 7" HICK.=S10°E 70.03'  
N & W IN E SIDE 12" HACKBERRY=S15°W 63.23'

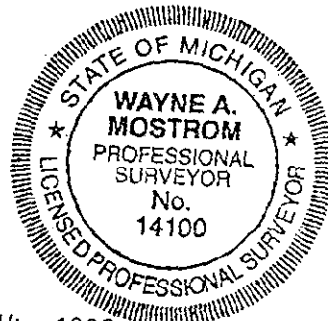

LIBER 5 PAGE 59

Signed by Wayne A. Mostrom WAYNE A. MOSTROM  
Surveyor's Michigan License No. 14100

Date APRIL 14, 1998

**REMONUMENTATION**