

SURVEY & REMONUMENTATION

JUL 16 1998

SECTION

LAND CORNER RECORDATION CERTIFICATE LIBER 5
 Filing Requirement of Act 74, Mich. P.A. 1970

PAGE 71
 STATE OF MICHIGAN
 ST. JOSEPH COUNTY
 FILED

For corners in

ST. JOSEPH Located In: Corner Code #
 (County)
MOTTVILLE TWP.
 1. Public Land Survey T 8S R 12W I-6
 T R
 T R
 T R
 T R
 2. Property Controlling S T R
 in Section S T R
 3. Miscellaneous S T R
 Property in Sec. S T R

11 JUN 1998 9:52:15 AM

CYNTHIA L. JARRATT
 REGISTER OF DEEDS

Register of Deeds Stamp & File Number

4. Lot No. _____, Recorded Plat _____
 5. Private Claims _____

I, WAYNE A. MOSTROM, in a field survey on 4/30, 19 98 do hereby state that under requirements of P.A. 74, Michigan P.A. of 1970, the corner points mentioned in lines 1 and 2 above were in conformance with regulations and rules therefore as required in the current manual of survey instructions of the United States Department of the Interior, Bureau of Land Management or by a decree of a Court of Law and /or that the corner points mentioned in lines 3, 4 and 5 above were in conformance with the rules of the Michigan Board of Land Surveyors or by a Decree of a Court of Law; established, re-established, monumented, recovered, found as expressed below:

NOTE: Not more than 2 corners, all in the same town and range, may be recorded on this certificate.

	A	B	C	D	E	F	G	H	I	J	K	L	M
1													
2	6		5		4		3		2		1		
3													
4	7		8		9		10		11		12		
5													
6	18		17		16		15		14		13		
7													
8	19		20		21		22		23		24		
9													
10	30		29		28		27		26		25		
11													
12	31		32		33		34		35		36		
13													

A. Description of original monument and accessories and/or subsequent restoration:

1880 SURVEY IN A/416 ROAD COMM. RECORD OF
SASSAFRAS STAKE SET SAYERS SURVEY - NOTES LOST
 3" CHESTNUT = S89°E 1.42 CH. + 'D STONE
 3" CHESTNUT = N30°E .79 CH. P.P. = NW 26.8' & NE 59.3'
 RR SIGN = NW 16.7'
 P.P. = SE 45.5'
 RR SIGN = SE 32.27'
 N. RAIL OF TRACK = S. 11.5'

MOSTROM 1981 SURVEY

FOUND BAR CAPPED #7874
 P. POLE = NW 26.8'
 P. POLE = NE 59.3'
 P. POLE = SE 45.5'
 N. RAIL OF TRACK = SOUTH 11.5'


B. Description of corner evidence found and/or method applied in restoring or reestablishing corner:

FOUND 3/8" X 15" BAR CAPPED #7874 7" DEEP IN ASPHALT RDWY.
 WITH + 'D STONE (BLUISH-GRAY) BELOW IRON IN LINE WITH FENCE TO WEST
 & IN CL OF BLUE SCHOOL RD. (PAVED)
 P.P. = NW 26.8'
 P.P. = NE 59.3'
 N. RAIL OF TRACKS = SOUTH 11.7'

RATIFIED BY PEER GROUP
 IN ACCORDANCE WITH P.A. 345
 ON May 11, 1998
Wayne CO. REPRESENTATIVE

C. Description of monument for corner and accessories established to perpetuate locating the position of the corner:

SET 5/8" X 22" BAR W/STD. CAP IN MON. BOX
 N & W IN NE SIDE P.P. = N60°W 27.23'
 N & W IN W. SIDE 20" WAL. = N15°E 99.27'
 N & W IN SE SDIE P.P. = N25°E 59.59'
 N & W IN SW SIDE DBL. ELM = S45°E 73.47'
 N & W IN SE SIDE RR TIE A.P. = S12°W 106.72'
 N. SIDE OF N. RAIL IN TRACKS = SOUTH 11.75'

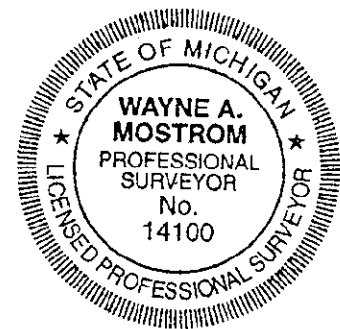

LIBER 5 PAGE 71

Signed by Wayne A. Mostrom
 Surveyor's Michigan License No. 14100

Date MAY 12, 1998