

SCHOOLCRAFT COUNTY  
PEER GROUP APPROVED

DATE 12/15/1999

JAN 25 2000

LAND CORNER RECORDATION CERTIFICATE  
Filing Requirement of Act 74, Michigan A 1997

SECTION

For corners in

SCHOOLCRAFT CO. REGISTER 1P  
Page 1 of 1 LC 4/316  
JLO Date 12/30/1999 Time 13:54:28  
RECORDING FEES: 9.00

Schoolcraft (County)	Located In:	Corner Code #
1. Public Land Survey	T 41N R 14W	M2
	T 41N R 13W	A2 ✓
	T R	
	T R	
2. Property Controlling in Section	S T R	
	S T R	
3. Miscellaneous Property in Sec.	S T R	
	S T R	

Register of Deeds Stamp & File Number

4. Lot No. \_\_\_\_\_, Recorded Plat \_\_\_\_\_  
5. Private Claims \_\_\_\_\_

I, Thomas P. O'Brien, in a field survey on 12/18, 1999 do hereby state that under requirements of P.A. 74, Michigan P.A. of 1970, the corner points mentioned in lines 1 and 2 above were in conformance with regulations and rules therefore as required in the current manual of survey instructions of the United States Department of the Interior, Bureau of Land Management or by a decree of a Court of Law and/or that the corner points mentioned in lines 3, 4 and 5 above were in conformance with the rules of the Michigan Board of Land Surveyors or by a Decree of a Court of Law; established, re-established, monumented, recovered, found as expressed below:

NOTE: Not more than 2 corners, all in the same town and range, may be recorded on this certificate.


1	A	B	C	D	E	F	G	H	I	J	K	L	M
2	6		5		4		3		2		1	X	
3													
4	7		8		9		10		11		12		
5													
6	18		17		16		15		14		13		
7													
8	19		20		21		22		23		24		
9													
10	30		29		28		27		26		25		
11													
12	31		32		33		34		35		36		
13													

A. Description of original monument and accessories and/or subsequent restoration:  
1845 John Burt, DS set qr. section post Cedar 10 S27E 4 Do 9 N73W 34  
Oct.27, 1977 Thomas P. O'Brien, Ps recovered 3/4" iron pipe. LCRC Liber 1, Page 170.  
1979 Schoolcraft County surveyor replaced 3/4" iron pipe with Schoolcraft County monument stamped to identify.

B. Description of corner evidence found and/or method applied in restoring or reestablishing corner:  
Dec.18, 1999 Thomas P. O'Brien, PS recovered Schoolcraft County monument. Recorded witnesses verify corner position.

C. Description of monument for corner and accessories established to perpetuate locating the position of the corner:

Schoolcraft County monument  
Witnesses:  
14" Maple S3°E 45.4'  
NE corner cabin S47°W 40.3'  
12" Spruce N10°W 34.3'  
SW corner log cabin N50°W 77.0'  
Carsonite Post North 15.0'

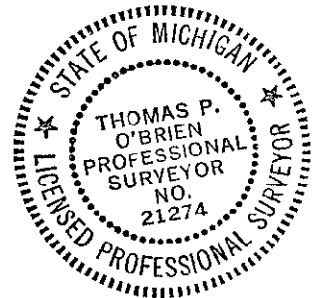

Signed by Thomas P. O'Brien  
Surveyor's Michigan License No. 21274

Date Dec. 30, 1999