

SCHOOLCRAFT COUNTY PEER GROUP APPROVED

JAN 30 1996

DATE May 12, 1995 LAND CORNER RECORDATION CERTIFICATE Filing Requirement of Act 74, Mich. P.A. 1970

COMMISSION

For corners in

Table with columns: Schoolcraft (County), Located In:, Corner Code #. Includes entries for Public Land Survey, Property Controlling in Section, and Miscellaneous Property in Sec.

Received & Filed this 6th day of Dec. 1995 at 11:37 AM Sigrid I. Hedberg Schoolcraft Co. Reg. of Deeds

Register of Deeds Stamp & File Number

4. Lot No. , Recorded Plat 5. Private Claims

Grid table with columns A-M and rows 2-13. Contains numbers 1-36 in a grid pattern.

Thomas P. O'Brien, in a field survey on Nov. 6, 1995, do hereby certify that under requirements of P.A. 74, Michigan P.A. of 1970, the corner points mentioned in lines 1 and 2 above were in conformance with regulations and rules therefore as required in the current manual of survey instructions of the United States Department of the Interior, Bureau of Land Management or by a decree of a Court of Law and/or that the corner points mentioned in lines 3, 4 and 5 above were in conformance with the rules of the Michigan Board of Land Surveyors or by a Decree of a Court of Law; established, re-established, monumented, re-monumented, recovered, found as expressed below:

NOTE: Not more than 4 corners, all in the same town and range, may be recorded on this certificate.

A. Description of original monument and accessories and/or subsequent restoration:


M-13 (S.E. Corner Sec. 36) Aug. 6, 1845 John Burt D.S. set post corner of Townships 41,42 North between Ranges 14,15 W. Fir 5 N51E 31 W. Birch 10 S61W 39

B. Description of corner evidence found and/or method applied in restoring or reestablishing corner:

M-13 Dec. 15 1976, Thomas P. O'Brien, RLS "found 2" pipe", in 1979 the pipe was replaced with a Schoolcraft Co. Monument. Liber 1, Page 21 Oct. 17, 1994 Thomas P. O'Brien, PS recovered Schoolcraft Co. Monument as set by Thomas P. O'Brien PS.

C. Description of monument for corner and accessories established to perpetuate locating the position of the corner:

M-13 Schoolcraft County monument. witnesses: 6" Cedar N30°E 23.30' 6" Cedar N85°E 18.90' 3" Cedar S33°W 11.22' 4" Cedar N77°W 66.30'

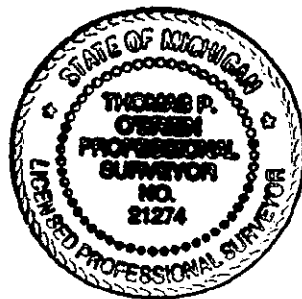

Signed by Thomas P. O'Brien, PS Date Dec. 4, 1995

Surveyor's Michigan License No. 21274