

SCHOOLCRAFT COUNTY PEER GROUP APPROVED

JAN 20 2000

DATE 11/8/99 DOB LAND CORNER RECORDATION CERTIFICATE
Filing Requirement of Act 74, Mich. P.A. 1970

SECTION

For corners in

<u>Schoolcraft</u> (County)	Located in:	Corner Code #
1. Public Land Survey	T41N R15W	M2
	T41N R14W	A2
	T R	
	T R	
2. Property Controlling in Section	S T R	
	S T R	
3. Miscellaneous Property in Sec.	S T R	
	S T R	

SIGRID HEDBERG 1P
SCHOOLCRAFT CO. REGISTER
Page 1 of 1 LC 4/298
JLO Date 12/22/1999 Time 13:52:11
RECORDING FEES: 9.00

Register of Deeds Stamp & File Number

4. Lot No. _____, Recorded Plat _____
5. Private Claims _____

I, Thomas P. O'Brien, in a field survey on 12/13, 1999 do hereby state that under requirements of P.A. 74, Michigan P.A. of 1970, the corner points mentioned in lines 1 and 2 above were in conformance with regulations and rules therefore as required in the current manual of survey instructions of the United States Department of the Interior, Bureau of Land Management or by a decree of a Court of Law and /or that the corner points mentioned in lines 3, 4 and 5 above were in conformance with the rules of the Michigan Board of Land Surveyors or by a Decree of a Court of Law; established, re-established, monumented, recovered, found as expressed below:

NOTE: Not more than 2 corners, all in the same town and range, may be recorded on this certificate.

A	B	C	D	E	F	G	H	I	J	K	L	M
1												
2	6		5		4		3		2		1	X
3												
4	7		8		9		10		11		12	
5												
6	18		17		16		15		14		13	
7												
8	19		20		21		22		23		24	
9												
10	30		29		28		27		26		25	
11												
12	31		32		33		34		35		36	
13												

A. Description of original monument and accessories and/or subsequent restoration:

Aug.16, 1845 J. Burt DS set qr. sec. post W Pine N36W 11 W Birch S28W 12

May 21, 1980 Robert E. Schmeling, RLS reestablished corner by proportionate measurement between M1 and M3.

B. Description of corner evidence found and/or method applied in restoring or reestablishing corner:


Dec.13, 1999 Thomas P. O'Brien, PS recovered pipe w/cap stamped to identify as set by Robert E. Schmeling, RLS. Added additional witness and Carsonite Post.

C. Description of monument for corner and accessories established to perpetuate locating the position of the corner:

1" pipe w/brass cap stamped to identify.

Witnesses:

- Pine Stump 18" N38°E 28.6'
- Cedar 8" S74°E 15.9'
- Cedar 7" S8°W 17.5'
- Cedar 4" N76°W 12.25'
- Carsonite POst North 1.0'

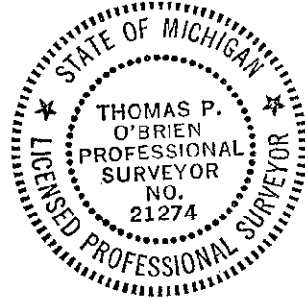

Signed by Thomas P. O'Brien
Surveyor's Michigan License No. 21274

Date 12/16/99