

**SCHOOLCRAFT COUNTY
PEER GROUP APPROVED
DATE 12/15/99 JOB**

JAN 17 2000
SECTION

**LAND CORNER RECORDATION CERTIFICATE
Filing Requirement of Act 74, Mich. P.A. 1970**

For corners in
Schoolcraft
(County)

Located In: Corner Code #

1. Public Land Survey	T 41N R 14W	B1 ✓
	T 42N R 14W	B13
	T ___ R ___	___
	T ___ R ___	___
2. Property Controlling in Section	S ___ T ___ R ___	___
	S ___ T ___ R ___	___
3. Miscellaneous Property in Sec.	S ___ T ___ R ___	___
	S ___ T ___ R ___	___

SIGRID HEDBERG
SCHOOLCRAFT CO. REGISTER 1P
Page 1 of 1
JLO Date 12/30/1999 LC 4/325
RECORDING FEES: Time 13:56:59
9.00

Register of Deeds Stamp & File Number

4. Lot No. _____, Recorded Plat _____
5. Private Claims _____

	A	B	C	D	E	F	G	H	I	J	K	L	M
1													
2	6		5		4		3		2		1		
3													
4	7		8		9		10		11		12		
5													
6	18		17		16		15		14		13		
7													
8	19		20		21		22		23		24		
9													
10	30		29		28		27		26		25		
11													
12	31		32		33		34		35		36		
13													

I, Thomas P. O'Brien in a field survey on 12/23, 1999 do hereby state that under requirements of P.A. 74, Michigan P.A. of 1970, the corner points mentioned in lines 1 and 2 above were in conformance with regulations and rules therefore as required in the current manual of survey instructions of the United States Department of the Interior, Bureau of Land Management or by a decree of a Court of Law and/or that the corner points mentioned in lines 3, 4 and 5 above were in conformance with the rules of the Michigan Board of Land Surveyors or by a Decree of a Court of Law; established, re-established, monumented, recovered, found as expressed below:

NOTE: Not more than 2 corners, all in the same town and range, may be recorded on this certificate.

A. Description of original monument and accessories and/or subsequent restoration:


April 1851 Algernon Merryweather, DS Remeasurement NBT's Balsam 6 N51E 23 " 3 N50W 3
Oct. 13, 1998 Keith R. Waters, PS reestablished corner by single proportionate measurement on the township line between corners at A1 and C1.

B. Description of corner evidence found and/or method applied in restoring or reestablishing corner:

Dec. 23, 1999 Thomas P. O'Brien, Ps recovered 1/2" rebar with plastic cap 33142 at corner. Verified by existing witnesses and distances to A1 and C1. Reset 1/2" rebar with Schoolcraft County monument stamped to identify.

C. Description of monument for corner and accessories established to perpetuate locating the position of the corner:

Schoolcraft County monument
Witnesses:
14" Maple S56°W 41.60'
10" Maple S10°W 50.65'
10" Fir S27°E 48.28'
12" Fir S80°E 112.85'
Carsonite Post South 20.0'

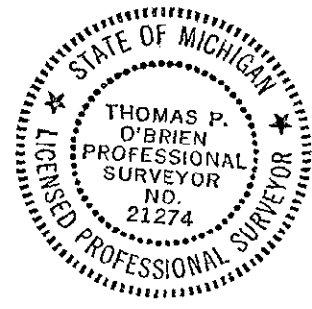

Signed by Thomas P. O'Brien

Surveyor's Michigan License No. 21274

Date Dec. 30, 1999