

**SCHOOLCRAFT COUNTY
PEER GROUP APPROVED**

JAN 25 2000

SECTION

DATE 12/15/99 OOB LAND CORNER RECORDATION CERTIFICATE

Filing Requirement of Act 74, Mich. P.A. 1970

For corners in

Schoolcraft (County)	Located In:	Corner Code #
1. Public Land Survey	T41N R14W T42N R14W T___ R___ T___ R___	F1 ✓ F13 _____ _____
2. Property Controlling in Section	S___ T___ R___ S___ T___ R___	_____ _____
3. Miscellaneous Property in Sec.	S___ T___ R___ S___ T___ R___	_____ _____

SIGRID HEDBERG 1P
SCHOOLCRAFT CO. REGISTER
Page 1 of 1 LC 4/329
JLQ Date 12/30/1999 Time 13:57:42
RECORDING FEES: 9.00

Register of Deeds Stamp & File Number

4. Lot No. _____, Recorded Plat _____
5. Private Claims _____

I, Thomas P. O'Brien, in a field survey on Dec. 20, 1999 do hereby state that under requirements of P.A. 74, Michigan P.A. of 1970, the corner points mentioned in lines 1 and 2 above were in conformance with regulations and rules therefore as required in the current manual of survey instructions of the United States Department of the Interior, Bureau of Land Management or by a decree of a Court of Law and/or that the corner points mentioned in lines 3, 4 and 5 above were in conformance with the rules of the Michigan Board of Land Surveyors or by a Decree of a Court of Law; established, re-established, monumented, recovered, found as expressed below:

NOTE: Not more than 2 corners, all in the same town and range, may be recorded on this certificate.

	A	B	C	D	E	F	G	H	I	J	K	L	M
1													
2	6		5		4		3		2		1		
3													
4	7		8		9		10		11		12		
5													
6	18		17		16		15		14		13		
7													
8	19		20		21		22		23		24		
9													
10	30		29		28		27		26		25		
11													
12	31		32		33		34		35		36		
13													

A. Description of original monument and accessories and/or subsequent restoration:

April 1851 Algernon Merryweather, DS remeasured line and established corner Spruce 6 in N60°E 7 Spruce 6 in N50°W 21

August 17, 1989 Gary E. Koepke, PS "Found old blazes north & south. Set 1/4 Cor. from traverse to be midway and on line between SW. Cor. Sec.33 and SE. Cor. Sec.33, and 12 ft. north of dead 7" spruce stub found blazed on 4 sides.

B. Description of corner evidence found and/or method applied in restoring or reestablishing corner:


Dec.20, 1999 Thomas P. O'Brien, PS found 3/8" iron rod w/RLS cap set in 1"x24" pipe. Found witnesses verify corner position. Reset iron bar w/ Schoolcraft County monument stamped to identify.

C. Description of monument for corner and accessories established to perpetuate locating the position of the corner:

Schoolcraft County monument

Witnesses:

- 6" Balsam S5°W 12.30'
- 6" Spruce S80°E 21.02'
- 9" Spruce N65°E 20.42'
- 6" Tamarack N27°W 17.65'

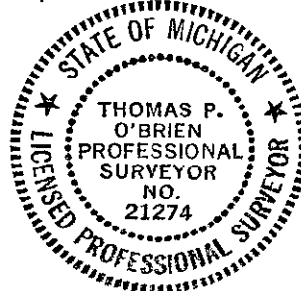

Thomas P. O'Brien

Signed by Thomas P. O'Brien

Date Dec. 22, 1999

Surveyor's Michigan License No. 21274