

**SCHOOLCRAFT COUNTY
PEER GROUP APPROVED**

JAN 5 2000

DATE 12/15/99 **LAND CORNER RECORDATION CERTIFICATE**
Filing Requirement of Act 74, Mich. P.A. 1970

SECTION

For corners in

Schoolcraft (County)	Located In:	Corner Code #
1. Public Land Survey	T <u>41</u> N <u>14</u> W	L1 ✓
	T <u>42</u> N <u>14</u> W	L13
	T ___ R ___	_____
	T ___ R ___	_____
2. Property Controlling in Section	S ___ T ___ R ___	_____
	S ___ T ___ R ___	_____
3. Miscellaneous Property in Sec.	S ___ T ___ R ___	_____
	S ___ T ___ R ___	_____

SIGRID HEDBERG 1P
SCHOOLCRAFT CO. REGISTER
Page 1 of 1 LC 4/317
JLV Date 12/30/1999 Time 13:54:47
RECORDING FEES: 9.00

Register of Deeds Stamp & File Number

4. Lot No. _____, Recorded Plat _____
5. Private Claims _____

	A	B	C	D	E	F	G	H	I	J	K	L	M
1													
2	6		5		4		3		2		1		
3													
4	7		8		9		10		11		12		
5													
6	18		17		16		15		14		13		
7													
8	19		20		21		22		23		24		
9													
10	30		29		28		27		26		25		
11													
12	31		32		33		34		35		36		
13													

I, Thomas P. O'Brien, in a field survey on 12/18, 1999 do hereby state that under requirements of P.A. 74, Michigan P.A. of 1970, the corner points mentioned in lines 1 and 2 above were in conformance with regulations and rules therefore as required in the current manual of survey instructions of the United States Department of the Interior, Bureau of Land Management or by a decree of a Court of Law and/or that the corner points mentioned in lines 3, 4 and 5 above were in conformance with the rules of the Michigan Board of Land Surveyors or by a Decree of a Court of Law; established, re-established, monumented, recovered, found as expressed below:

NOTE: Not more than 2 corners, all in the same town and range, may be recorded on this certificate.

A. Description of original monument and accessories and/or subsequent restoration:


1845 John Burt, DS set qr. section post Cedar 4 N24E 16 Do 5 N43W 18
Aug. 10, 1967 Billy D. Buckler, RLS "This corner replaced in intersection of roads; East, West, South and in line with and old fence line, bearing North.
Mr. Dixner, a local resident, remembers an iron being in this location and saw it pulled out by road graders."

B. Description of corner evidence found and/or method applied in restoring or reestablishing corner:

Dec. 18, 1999 Thomas P. O'Brien, PS found 1/2" iron bar in road intersection. Road centerlines E,W,S and old fence verify corner position. Reset iron road with 1/2" iron bar w/OBRIEN 21274 cap in monument box.

C. Description of monument for corner and accessories established to perpetuate locating the position of the corner:

- 1/2" Iron bar w/OBRIEN 21274 cap in monument box.
- Witnesses:
- Power Pole S47°W 52.20'
- 8" Spruce S4°W 76.45'
- 14" Spruce N30°E 71.40'
- 12" Cedar N7°W 78.55'
- Carsonite Post North 35.0'

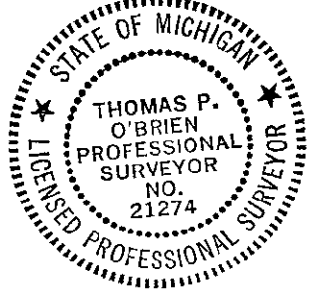

Thomas P. O'Brien

Signed by Thomas P. O'Brien
Surveyor's Michigan License No. 21274

Date Dec. 30, 1999