

SCHOOLCRAFT COUNTY PEER GROUP APPROVED

SURVEY &
REMONUMENTATION

DATE 10/21/98 JOB LAND CORNER RECORDATION CERTIFICATE
Filing Requirement of Act 74, Mich. P.A. 1970

JAN 21 1999

For corners in

<u>Schoolcraft</u> (County)	Located in:	Corner Code #
1. Public Land Survey	<u>T41N R 16W</u>	<u>B-13</u>
	T <u> </u> R <u> </u>	<u> </u>
	T <u> </u> R <u> </u>	<u> </u>
	T <u> </u> R <u> </u>	<u> </u>
2. Property Controlling in Section	S <u> </u> T <u> </u> R <u> </u>	<u> </u>
	S <u> </u> T <u> </u> R <u> </u>	<u> </u>
3. Miscellaneous Property in Sec.	S <u> </u> T <u> </u> R <u> </u>	<u> </u>
	S <u> </u> T <u> </u> R <u> </u>	<u> </u>

SECTION

SIGRID HEDBERG 1P
SCHOOLCRAFT CO. REGISTER
Page 1 of 1 LC 4/ 223
JLO Rec. Date 12/03/98 Time 14:31
REVENUE FEES: 9.00

Register of Deeds Stamp & File Number

4. Lot No. _____, Recorded Plat _____
5. Private Claims _____

Thomas P. O'Brien in a field survey on Oct. 28, 19 98 do hereby state that under requirements of P.A. 74, Michigan P.A. of 1970, the corner points mentioned in lines 1 and 2 above were in conformance with regulations and rules therefore as required in the current manual of survey instructions of the United States Department of the Interior, Bureau of Land Management or by a decree of a Court of Law and /or that the corner points mentioned in lines 3, 4 and 5 above were in conformance with the rules of the Michigan Board of Land Surveyors or by a Decree of a Court of Law, established, re-established, monumented, recovered, found as expressed below:

NOTE: Not more than 2 corners, all in the same town and range, may be recorded on this certificate.

	A	B	C	D	E	F	G	H	I	J	K	L	M
1													
2	6		5		4		3		2		1		
3													
4	7		8		9		10		11		12		
5													
6	18		17		16		15		14		13		
7													
8	19		20		21		22		23		24		
9													
10	30		29		28		27		26		25		
11													
12	31		32		33		34		35		36		
13													

A. Description of original monument and accessories and/or subsequent restoration:


B13 S 1/4 Corner Section 31, T41N - R16W
1848 - John Burt D.S. set qr. section post referenced by:
Cedar 10 N 55 E 18 .

Sept. 26, 1912 - Ernest Weaver, County Surveyor set wood stake from original witness, Cedar 10 N 55 E 18.

Dec. 1982 - LCRC by Thomas P. O'Brien (L.1 Pg.296 P.S. 21274) indicates corner was reestablished by single proportionate measure, set Schoolcraft County Monument stamped to identify.

B. Description of corner evidence found and/or method applied in restoring or reestablishing corner:

B13 Oct. 28, 1998 - Thomas P. O'Brien P.S. recovered Schoolcraft County Monument with broken top. Replaced with Schoolcraft County Monument stamped to identify from existing BT's, 10" Maple - S72°W - 23.50' 10" Maple Clump - N51°W - 43.65'.

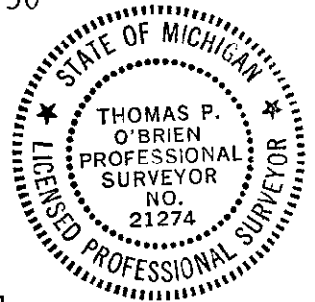

C. Description of monument for corner and accessories established to perpetuate locating the position of the corner:

B13 Schoolcraft County Monument stamped to identify. Repainted blazes on NBT's and made measurements to the following references:

- (Fd.) 10" Maple - S72°W - 23.50'
- (Fd.) 10" Maple - N51°W - 43.65'
- (Fd.) Schoolcraft County Monument, NW Corner Section 1, T40N - R17W East - 93.0'
- NBT 12" Maple - N68°E - 58.05'
- Carsonite post - West - 15.0'

Signed by Thomas P. O'Brien Date November 23, 1998

Surveyor's Michigan License No. 21274