

**SCHOOLCRAFT COUNTY
PEER GROUP APPROVED**

DATE 10/21/98 JOB

SURVEY &
REMONUMENTATION

JAN 21 1999

**LAND CORNER RECORDATION CERTIFICATE
Filing Requirement of Act 74, Mich. P.A. 1970**

SECTION _____

For corners in

<u>Schoolcraft</u> (County)	Located In:	Corner Code #
1. Public Land Survey	<u>T41NR16W</u>	<u>C-7</u>
	T ___ R ___	_____
	T ___ R ___	_____
	T ___ R ___	_____
2. Property Controlling in Section	S ___ T ___ R ___	_____
	S ___ T ___ R ___	_____
3. Miscellaneous Property in Sec.	S ___ T ___ R ___	_____
	S ___ T ___ R ___	_____

SIGRID HEDBERG
SCHOOLCRAFT CO. REGISTER 1P
Page 1 of 1 LC 4/224
JLO Rec. Date 12/03/98 Time 14:32
REVENUE FEES: 9.00

Register of Deeds Stamp & File Number

4. Lot No. _____, Recorded Plat _____
5. Private Claims _____

	A	B	C	D	E	F	G	H	I	J	K	L	M
1													
2		6		5		4		3		2		1	
3													
4		7		8		9		10		11		12	
5													
6		18		17		16		15		14		13	
7			X										
8		19		20		21		22		23		24	
9													
10		30		29		28		27		26		25	
11													
12		31		32		33		34		35		36	
13													

Thomas P. O'Brien in a field survey on Oct. 23, 1998 do hereby state that under requirements of P.A. 74, Michigan P.A. of 1970, the corner points mentioned in lines 1 and 2 above were in conformance with regulations and rules therefore as required in the current manual of survey instructions of the United States Department of the Interior, Bureau of Land Management or by a decree of a Court of Law and/or that the corner points mentioned in lines 3, 4 and 5 above were in conformance with the rules of the Michigan Board of Land Surveyors or by a Decree of a Court of Law, established, re-established, monumented, recovered, found as expressed below:


NOTE: Not more than 2 corners, all in the same town and range, may be recorded on this certificate.

A. Description of original monument and accessories and/or subsequent restoration:

- C7 NW Corner Section 20, T41N - R16W
 Sept. 13, 1845 - John Burt D.S. set post corner of sections 17,18,19 & 20
 referenced by : Cedar 7 N 18 W 26 Cedar 6 S 55 E 13
 April 21, 1983 - LCRC by David B. Babbitt (L.1 Pg. 320 P.S. 21558).
 Oct. 13, 1993 - LCRC by Gary E. Koepke (L.2 Pg. 355 L.S. 26458).
 March 27, 1995 - LCRC by Gerald W. Carlson (L.4 Pg. 168 P.S. 24589).

B. Description of corner evidence found and/or method applied in restoring or reestablishing corner:

- C7 Oct. 23, 1998 - Thomas P. O'Brien P.S. recovered a 1/2" Iron Bar with cap LS 26458 G. Koepke in Mon. Box 5.2' North of Blk. Top edge. References fd. varify corner location as found by Carlson 3/27/95.

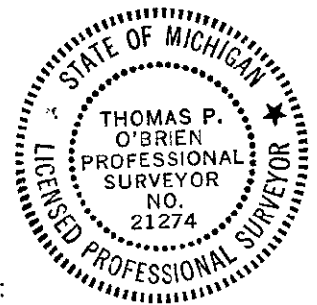

C. Description of monument for corner and accessories established to perpetuate locating the position of the corner:

- C7 1/2" Iron Bar with 26458 G. Koepke cap in Monument Box 5.2' North of black top edge. Repainted the blazes on the following NBT's and made measurements to the following references:
- (Fd.) 11" Tamarack - N23°W - 73.86' Carsonite post - North - 20.0'
 - (Fd.) 9" Cedar - N47°E - 40.36'
 - (Fd.) Power Pole - N71°E - 34.55'
 - (Fd.) Power Pole - S70°W - 180.07'
 - (Fd.) Power Pole - S39°E - 119.31'
 - (Fd.) Con. R/W Marker - N5°E - 40.44'
 - (Fd.) Monument Box with boat spike 1.5' South of C/L M-149, South - 19.75'

Signed by Thomas P. O'Brien Date November 23, 1998

Surveyor's Michigan License No. 21274